

RECORDED

99 SEP 23 PM 3: 21

FEB 24 2000

OTTAWA COUNTY REMONUMENTATION
LAND CORNER RECORDATION CERTIFICATE
Filing Requirement of Act 74, Mich. P.A. 1970

Doug Koning
REGISTER OF DEEDS
OTTAWA COUNTY, MI

For corners in

<u>Ottawa</u> (County)	Located in:	Corner Code #
1. Public Land Survey	T <u>6N</u> R <u>R15W</u>	J-1
	T _____ R _____	(N 1/4 cor., Sec. 2
	T _____ R _____	Olive Twp.)
	T _____ R _____	
2. Property Controlling in Section	S _____ T _____ R _____	
	S _____ T _____ R _____	
3. Miscellaneous Property In Sec.	S _____ T _____ R _____	
	S _____ T _____ R _____	
4. Lot No. _____, Recorded Plat _____		
5. Private Claims _____		

Register of Deeds Stamp & File Number

A	B	C	D	E	F	G	H	I	K	L
2	6	5	4	3	2	1				
3										
4	7	8	9	10	11	12				
5										
6	18	17	16	15	14	13				
7										
8	19	20	21	22	23	24				
9										
10	30	29	28	27	26	25				
11										
12	31	32	33	34	35	36				
13										

I, Douglas J. Koning, in a field survey on August 26, 1999, do hereby certify that under requirements of P.A. 74, Michigan P.A. of 1970, the corner points mentioned in lines 1 and 2 above were in conformance with regulations and rules therefore as required in the current manual of survey instructions of the United States Department of the Interior, Bureau of Land Management or by a decree of a Court of Law and/or that the corner points mentioned in lines 3,4 and 5 above were in conformance with the rules of the Michigan Board of Land Surveyors or by a Decree of a Court of Law; established, re-established, monumented, re-monumented, recovered, found as expressed below:

NOTE: Not more than 4 corners, all in the same town and range, may be recorded on this certificate.

A. Description of original monument and accessories and/or subsequent restoration:
J-1 Government Notes—did not set

L.C.R.C. Liber 1, Page 813, Dec. 1972 (F. E. Spicer)	L.C.R.C. Liber 3, Page 208, Nov. 1977 (W. R. Byl)	L.C.R.C. Liber 6, Page 76, Dec. 1990 (R. Milliron)
J-1 Plow Point with iron 0.1' West	J-1 Cast Monument in Box	J-1 Reset Cast Iron Monument
CP Pole S55°E 42.5'	Tel. pole NE 28.20'	East 67.03' to Robinson corner
Street Sign S20°W 22.5'	Power Pole SE 42.95'	S40°E 41.95' to Nail in N. side Power Pole
Stump N10°W 30.9'	Centerline Street Sign SSW 22.52'	S20°W 60.30' to Nail in NW side fence pos
24" Maple N60°E 86.3'	20" Stump NNW 31.20'	N50°W 118.85' to Nail in E side 10" Elm
C rds W 45'±	Centerline N-S Road W 45'	


B. Description of corner evidence found and/or method applied in restoring or reestablishing corner.

J-1 Found Cast Iron Monument in Box	
Found Nail in SW side new Power pole	SW 42.30'
Found PK Nail in NW side new pole	SW 41.88'
Found Nail in N side old Power pole (cut off)	SW 42.60'
Centerline Street sign	SSW 22.64'
Centerline 108th Avenue to South,	W 41'
Found Nail in Ely side 12" dead tree	NW 118.92'
Found O.C. Remon Nail & Tag In Ely side 12" dead tree	N50°W 118.93'
Robinson Twp. Corner (J-13, T7N, R15W)	E 67.03'

This corner was not monumented by the original GLO survey. This monument is accepted as the best available evidence of the position of the corner.

C. Description of monument for corner and accessories established to perpetuate locating the position of the corner.

J-1 Cast Iron Monument 0.15' South of Township line, in monument box	
NW corner concrete block foundation to House #10782	S46°E 117.59'
Set Remon Tag & Nail in SW side power pole	S41°E 42.36'
Set Remon Tag & Nail in Sly side power pole	S88°W 273.12'
Set Remon Tag & Nail in Sly Side power pole	N72°W 154.54'
Found Remon Tag & Nail in Sly side power pole	N78°E 179.77'
SW corner Brick on House #10805	N67°E 236.95'
Robinson Twp. Corner (J-13, T7N, R15W)	East 67.03'
Centerline of road to South,	West 41'

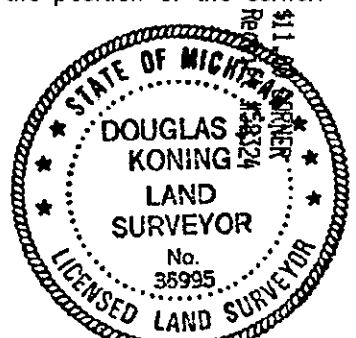

Signed by Douglas J. Koning (see sketch on back) Date 9-13-99
Surveyor's Michigan License No. 35995


Liber 4 Page 402

FEB 24 2000

SECTION

SECTION 35, T7N, R15W
ROBINSON TOWNSHIP

SECTION 2, T6N, R15W
OLIVE TOWNSHIP

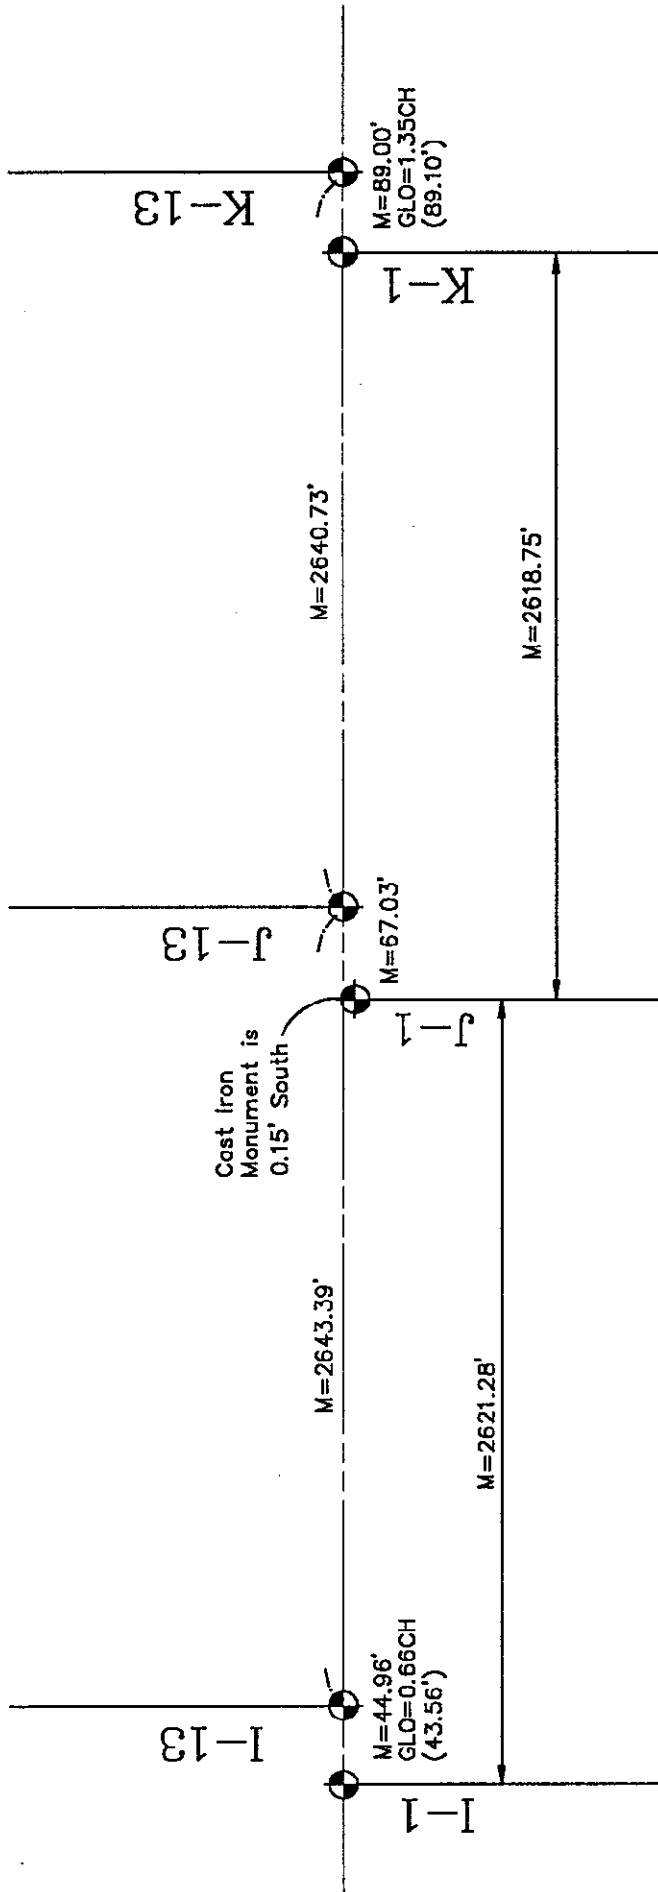

NO SCALE