

**SURVEY &
REMONUMENTATION**

FEB 27 1998

SECTION

**OTTAWA COUNTY REMONUMENTATION
LAND CORNER RECORDATION CERTIFICATE**

RECORDED

For corners in

Filing Requirement of Act 74, Mich. P.A. 1970 **97 DEC -8 AM 11:30**

<u>Ottawa</u> (County)	Located in:	Corner Code #
1. Public Land Survey	T <u>6N</u> R <u>R15W</u>	<u>J-9</u> (S 1/4 cor., Sec. 23 Olive Twp.)
	T _____ R _____	_____
	T _____ R _____	_____
	T _____ R _____	_____
2. Property Controlling in Section	S _____ T _____ R _____	_____
	S _____ T _____ R _____	_____
3. Miscellaneous Property in Sec.	S _____ T _____ R _____	_____
	S _____ T _____ R _____	_____
4. Lot No. _____, Recorded Plat _____		
5. Private Claims _____		

Doug Koning
REGISTER OF DEEDS
OTTAWA COUNTY, MI

Register of Deeds Stamp & File Number

I, Douglas J. Koning, in a field survey on 11-12, 1997, do hereby certify that under requirements of P.A. 74, Michigan P.A. of 1970, the corner points mentioned in lines 1 and 2 above were in conformance with regulations and rules therefore as required in the current manual of survey instructions of the United States Department of the Interior, Bureau of Land Management or by a decree of a Court of Law and/or that the corner points mentioned in lines 3, 4 and 5 above were in conformance with the rules of the Michigan Board of Land Surveyors or by a Decree of a Court of Law; established, re-established, monumented, re-monumented, recovered, found as expressed below:

NOTE: Not more than 4 corners, all in the same town and range, may be recorded on this certificate.

	A	B	C	D	E	F	G	H	I	J	K	L	M
2	6	5	4	3	2	1							
3													
4	7	8	9	10	11	12							
5													
6	18	17	16	15	14	13							
7													
8	19	20	21	22	23	24							
9													
10	30	29	28	27	26	25							
11													
12	31	32	33	34	35	36							
13													

A. Description of original monument and accessories and/of subsequent restoration:

J-9 Government Notes	L.C.R.C. Liber 5, Page 322 August 1988
Set Post May 1832	J-9 Set CIM
By Calvin Britain D.S.	Power Pole S 59.6'
Beech 6" N12°E 13 Links	6" Sassafras N 49.2'
Maple 10" S24°E 27 Links	
	L.C.R.C. Liber 3, Page 320 January 1979
	J-9 Nail in Telephone Pole SSE 59.67'
	NW corner Sec. 26 W 2632.51'

B. Description of corner evidence found and/or method applied in restoring or reestablishing corner.

F-9 Found Cast Iron Monument in Monument Box in Centerline of Bit. Road
 Found Nail & Tag #14091 in East Side of Power Pole SSE 59.59'
 Found Nail in East Side 8" Sassafras N 49.23'
 NW corner Section 26 Cast Iron Monument in Box W 2632.62

P.A. 345 OTTAWA COUNTY

PEER APPROVED 11-17-97


D.J.K.

This marker is accepted as a careful and faithful perpetuation of the position of the original corner.

C. Description of monument for corner and accessories established to perpetuate locating the position of the corner.

F-9 Cast Iron Monument in Box (in centerline of bit road)	
Set Remon Nail & Tag in East Side Power Pole	South 59.57'
Set Remon Nail & Tag in Northerly Side Power Pole	S76°E 375.74'
Set Remon Nail & Tag in Northerly Side Power Pole	S84°W 336.43'
Set Remon Nail & Tag in East Side 8" Sassafras	North 49.28'
NW corner Section 26, T6N, R15W Cast Iron Monument	West 2632.62'

\$ 9.00 CORNER
\$ 1.00 PHOTO

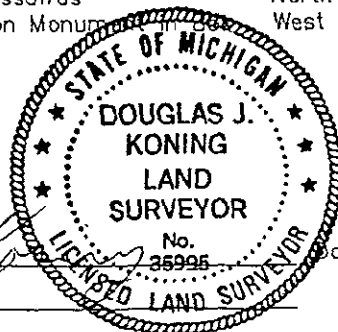

Signed by Douglas J. Koning Date 11-17-97
 Surveyor's Michigan License No. 35995