

SURVEY &
REMONUMENTATION

APR 05 1996

COMMISSION OTTAWA COUNTY REMONUMENTATION
LAND CORNER RECORDATION CERTIFICATE

For corners in _____ Filing Requirement of Act 74, Mich. P.A. 1970

RECORDED

95 NOV 15 PM 2: 12

Ottawa (County)	Located in:	Corner Code #
1. Public Land Survey	T 6N R 15W	J-13
	T _____ R _____	(S 1/4 cor., Sec. 35
	T _____ R _____	Olive Twp.)
	T _____ R _____	_____
2. Property Controlling in Section	S _____ T _____ R _____	_____
	S _____ T _____ R _____	_____
3. Miscellaneous Property in Sec.	S _____ T _____ R _____	_____
	S _____ T _____ R _____	_____
4. Lot No. _____, Recorded Plat _____		
5. Private Claims _____		

Edgar A. Robinson
REGISTER OF DEEDS
OTTAWA COUNTY, MI

Register of Deeds Stamp & File Number

	A	B	C	D	E	F	G	H	I	J	K	L	M
2	6	5	4	3	2	1							
3													
4	7	8	9	10	11	12							
5													
6	18	17	16	15	14	13							
7													
8	19	20	21	22	23	24							
9													
10	30	29	28	27	26	25							
11													
12	31	32	33	34	35	36							
13													

I, Douglas J. Koning, In a field survey on October 14, 1995, do hereby certify that under requirements of P.A. 74, Michigan P.A. of 1970, the corner points mentioned in lines 1 and 2 above were in conformance with regulations and rules therefore as required in the current manual of survey instructions of the United States Department of the Interior, Bureau of Land Management or by a decree of a Court of Law and/or that the corner points mentioned in lines 3,4 and 5 above were in conformance with the rules of the Michigan Board of Land Surveyors or by a Decree of a Court of Law; established, re-established, monumented, re-monumented, recovered, found as expressed below:

NOTE: Not more than 4 corners, all in the same town and range, may be recorded on this certificate.

A. Description of original monument and accessories and/of subsequent restoration:

J-13 Government Notes Set Post May 1832 Hemlock 30° N46°E 40 Links Leo 10° N10°W 6 Links	L.C.R.C. Liber 2, Page 225, June 1973 J-13 Found "T" Iron Pow. Pole SW 64.56' Centerline St. Sign S 29.45' Pow. Pole NE 178.45'
---	---

L.C.R.C. Liber 3, Page 212, November 1977 J-13 Set Cast Iron Monument Pow. Pole ENE 178.93' Centerline St. Sign S 29.45' Pow. Pole SW 65.18'
--

P.A. 345 OTTAWA COUNTY
PEER APPROVED 10/23/95

Keddy P. Redwood
DON

B. Description of corner evidence found and/or method applied in restoring or reestablishing corner.


J-13 Found Cast Iron Monument in Box 1' deep Found Nail N. side Pow. Pole SW 65.21' Found Nail S. side Pow. Pole NE 178.84' Street Sign S 35.57'

This marker is accepted as a careful and faithful perpetuation of the original corner.

C. Description of monument for corner and accessories established to perpetuate locating the position of the corner.

J-13 Set Form Pin & O.C. Remon Cap above Cast Iron Monument Set O.C. Remon Tag & Nail N side Pow. Pole S80°W 289.32' Set O.C. Remon Tag & Nail N side Pow. Pole S30°W 64.93' Set O.C. Remon Tag & Nail N side Pow. Pole N45°E 178.73' Cut "X" W end conc. culvert N20°W 253.49' Cast Iron Monument EAST 50.45' In Centerline E & W Road 6' E of Centerline Road to N

Signed by Douglas J. Koning
Surveyor's Michigan License No. _____

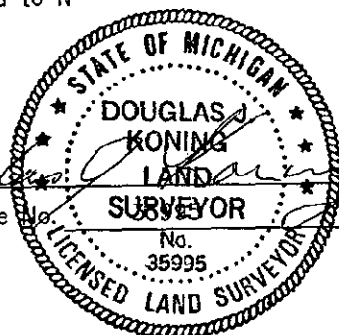

Date 10-20-95