

**SURVEY & REMONUMENTATION**

**FEB 27 1998**

**RECORDED**

**97 OCT 30 AM 10:59**

**SECTION**

**OTTAWA COUNTY REMONUMENTATION  
LAND CORNER RECORDATION CERTIFICATE**

For corners in

Filing Requirement of Act 74, Mich. P.A. 1970

*Delena Gant*

**Register of Deeds  
Ottawa County, MI**

<u>Ottawa</u> (County)	Located in:	Corner Code #
1. Public Land Survey	T 6N R 15W	K-2
	T R	(W 1/4 cor., Sec. 1
	T R	Olive Twp.)
	T R	
2. Property Controlling in Section	S T R	
	S T R	
3. Miscellaneous Property in Sec.	S T R	
	S T R	
4. Lot No. _____; Recorded Plat _____		
5. Private Claims _____		

**Register of Deeds Stamp & File Number**

A	B	C	D	E	F	G	H	I	J	K	L	M
2	6	5	4	3	2	▲	1					
3												
4	7	8	9	10	11	12						
5												
6	18	17	16	15	14	13						
7												
8	19	20	21	22	23	24						
9												
10	30	29	28	27	26	25						
11												
12	31	32	33	34	35	36						
13												

I, Douglas J. Koning, in a field survey on September 3, 1997, do hereby certify that under requirements of P.A. 74, Michigan P.A. of 1970, the corner points mentioned in lines 1 and 2 above were in conformance with regulations and rules therefore as required in the current manual of survey instructions of the United States Department of the Interior, Bureau of Land Management or by a decree of a Court of Law and/or that the corner points mentioned in lines 3, 4 and 5 above were in conformance with the rules of the Michigan Board of Land Surveyors or by a Decree of a Court of Law; established, re-established, monumented, re-monumented, recovered, found as expressed below:

**NOTE: Not more than 4 corners, all in the same town and range, may be recorded on this certificate.**

**A. Description of original monument and accessories and/or subsequent restoration:**

K-2 Government Notes Set Post May 1832 By Calvin Britain D.S. White Ash 24" S70°W 16 Links Birch 12" S26°E 12 Links	L.C.R.C. Liber 3, Page 90, June 1976 K-2 Re-Rod in Monument Box Guy Pole SE 53.20' Power Pole SW 45.90' Guy Pole NW 47.18' Centerline Road S 2.0'±	L.C.R.C. Liber 3, Page 206, November 1977 K-2 Cast Iron Monument Tel. Pole NW 37.20' Tel. Pole SE 53.24' Power Pole SW 45.98'
		L.C.R.C. Liber 5, Page 339, November 1988 K-2 CI Mon. in Mon. Box Nail & Tag #18042 in NE side Guy Pole SE 53.22' PK Nail in SE side Power Pole SW 49.86' PK Nail in NE side wood post at Tel. Box NW 38.56'

**B. Description of corner evidence found and/or method applied in restoring or reestablishing corner.**

K-2 Found Cast Iron Mon in Mon Box 3'± North of centerline  
Found P.K. Nail in Se side Power Pole (stub) SW 49.75'  
Found P.K. Nail in SE side Power Pole (new) SE 45.33'  
Found P.K. Nail in NE side Guy Pole (stub) SE 53.21'  
Found Nail & Tag #16042 in NE side Guy Pole (stub) SE 53.21'  
Found Nail in face of Guy Pole (stub) SE 52.72'  
Found P.K. Nail in NE side Wood Post @ Tel. Box NW 38.83'  
Found P.K. Nail in SE side Pole NE 158.88'

**P.A. 345 OTTAWA COUNTY**  
**PEER APPROVED** 10/27/97

*[Signature]*


This marker is accepted as a careful and faithful perpetuation of the original corner.

**C. Description of monument for corner and accessories established to perpetuate locating the position of the corner.**

K-2 Cast Iron Mon in Mon Box  
Set Ottawa County Remon Nail & Tag in SE side Power Pole S37°W 45.32'  
Set Ottawa County Remon Nail & Tag in NE side Guy Pole (new) S45°E 53.46'  
Set Ottawa County Remon Nail & Tag in NE side Wood Post @ Tel. Box N35°W 38.81'  
Set Ottawa County Remon Nail & Tag in NW side Power Pole N68°E 158.79'  
Centerline East-West road South 3'

\$ 9.00 CORNER  
\* 1.00 PHOTO

Signed by Douglas J. Koning  
Surveyor's Michigan License No. 35995

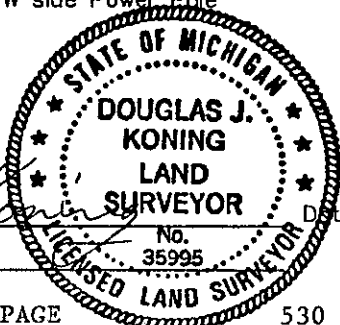

Date 10-27-97