

SURVEY & REMONUMENTATION

APR 25 1995

COMMISSION OTTAWA COUNTY REMONUMENTATION LAND CORNER RECORDATION CERTIFICATE

RECORDED
94 DEC -8 PM 12:36

D. J. Koning
REGISTER OF DEEDS
OTTAWA COUNTY, MI

For corners in _____ Filing Requirement of Act 74, Mich. P.A. 1970

Ottawa (County)	Located in:	Corner Code #
1. Public Land Survey	T 6N R 15W	K-3
	T _____ R _____	(NW Cor., Sec.
	T _____ R _____	12, Olive Twp.)
	T _____ R _____	_____
2. Property Controlling In Section	S _____ T _____ R _____	_____
	S _____ T _____ R _____	_____
3. Miscellaneous Property in Sec.	S _____ T _____ R _____	_____
	S _____ T _____ R _____	_____

Register of Deeds Stamp & File Number

4. Lot No. _____, Recorded Plat _____
5. Private Claims _____

	A	B	C	D	E	F	G	H	I	J	K	L	M
2	6	5	4	3	2	1							
3											▲		
4	7	8	9	10	11	12							
5													
6	18	17	16	15	14	13							
7													
8	19	20	21	22	23	24							
9													
10	30	29	28	27	26	25							
11													
12	31	32	33	34	35	36							
13													

I, Douglas J. Koning, in a field survey on October 21, 1994, do hereby certify that under requirements of P.A. 74, Michigan P.A. of 1970, the corner points mentioned in lines 1 and 2 above were in conformance with regulations and rules therefore as required in the current manual of survey instructions of the United States Department of the Interior, Bureau of Land Management or by a decree of a Court of Law and/or that the corner points mentioned in lines 3, 4 and 5 above were in conformance with the rules of the Michigan Board of Land Surveyors or by a Decree of a Court of Law; established, re-established, monumeter, re-monumented, recovered, found as expressed below:

NOTE: Not more than 4 corners, all in the same town and range, may be recorded on this certificate.

A. Description of original monument and accessories and/of subsequent restoration:

K-3 Government Notes	L.C.R.C. Liber 1, Page 687 October 1972	L.C.R.C. Liber 3, Page 90 June 1976
Set Post May 1832	K-3 PK Nail	K-3 Cast Iron Monument
By Calvin Britain, D.S.	Centerline Bridge	20" Maple
Maple 8" S1°E 6.40 Links	S line bridge	S face S Bridge wall
	12" Ash	SW cor. NW Headwall
	24" Clump Maple	SE cor. NE Headwall
	E & W	S60°W 83.20'
	S 0.80'	N 1.50'
	W 44.80'	N45°W 42.15'
	S40°E 33.50'	N45°E 43.90'

B. Description of corner evidence found and/or method applied in restoring or reestablishing corner.

K-3 Found Cast Iron Monument
S face S Bridge wall N 1.50'
SW cor. NW Headwall N45°W 42.15'
SE cor. NE Headwall N45°E 43.90'


P.A. 345 OTTAWA COUNTY
PEER APPROVED 11/21/94

Maday D. Hedewald

This marker is accepted as a careful and faithful perpetuation of the original corner.

C. Description of monument for corner and accessories established to perpetuate locating the position of the corner.

K-3 Cast Iron Monument (± on centerline 104th, 13'± N of centerline Taylor)
Set O.C. Remon Nail & Tag Nly side 26" Oak S70°W 83.53'
Set O.C. Remon Nail & Tag S side 12" Maple N80°W 89.83'
S face S Bridge wall N 1.50'
SW cor. NW Headwall N45°W 42.15'
SE cor. NE Headwall N45°E 43.90'

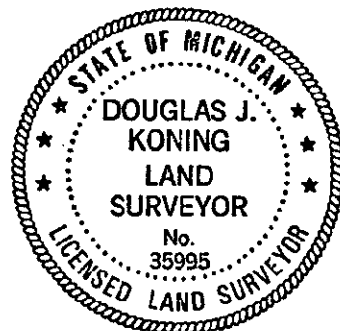

Signed by Douglas J. Koning
Surveyor's Michigan License No. 35995

Date November 14, 1994