

**SURVEY &
REMONUMENTATION**

APR 25 1995

**OTTAWA COUNTY REMONUMENTATION
LAND CORNER RECORDATION CERTIFICATE**

RECORDED

94 DEC -8 PM 12:36


For corners in **COMMISSION** Filing Requirement of Act 74, Mich. P.A. 1970

Phyllis Bellman
REGISTER OF DEEDS
OTTAWA COUNTY, MI

Ottawa (County)	Located in:	Corner Code #
1. Public Land Survey	T 6N R 15W	K-6
	T _____ R _____	(W 1/4 cor., Sec.
	T _____ R _____	13, Olive Twp.)
	T _____ R _____	
2. Property Controlling In Section	S _____ T _____ R _____	
	S _____ T _____ R _____	
3. Miscellaneous Property in Sec.	S _____ T _____ R _____	
	S _____ T _____ R _____	

Register of Deeds Stamp & File Number

4. Lot No. _____, Recorded Plat _____
5. Private Claims _____

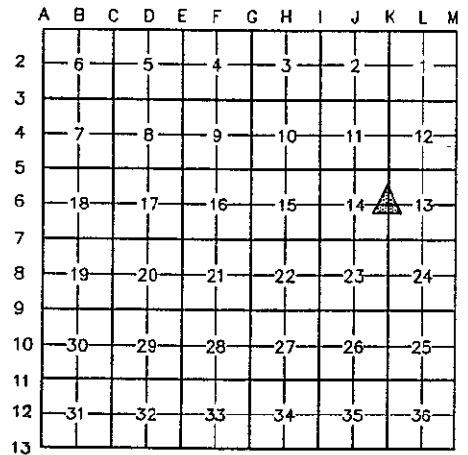

I, Douglas J. Koning, in a field survey on October 10, 1994, do hereby certify that under requirements of P.A. 74, Michigan P.A. of 1970, the corner points mentioned in lines 1 and 2 above were in conformance with regulations and rules therefore as required in the current manual of survey instructions of the United States Department of the Interior, Bureau of Land Management or by a decree of a Court of Law and/or that the corner points mentioned in lines 3, 4 and 5 above were in conformance with the rules of the Michigan Board of Land Surveyors or by a Decree of a Court of Law; established, re-established, monumented, re-monumented, recovered, found as expressed below:

NOTE: Not more than 4 corners, all in the same town and range, may be recorded on this certificate.

A. Description of original monument and accessories and/of subsequent restoration:

K-6 Government Notes Set Post May 1832 By Calvin Britain, D.S. Hemlock 15" West 2 Links Leo 12" S73E 31 Links	L.C.R.C. Liber 1, Page 425 June 1972 K-6 Found Steel Rod 20" Oak SE 43.35' NE School House Corner SW 98.80' Tel. Pole NW 39.60' 8" Catalpa NE 42.60'	L.C.R.C. Liber 3, Page 209, November 1976 K-6 Set Cast Iron Monument Tel. Pole NW 39.60' 10" Catalpa NE 43.10' 20" Oak SE 44.04'
	L.C.R.C. Liber 2, Page 711 November 1974 K-6 Found 5/8" Coated Pipe Tel. Pole N50W 39.78' 10" Tree N40E 42.89' Street Sign Post S50E 33.30' 18" Oak S40E 44.28'	L.C.R.C. Liber 3, Page 351 June 1979 K-6 Found Cast Iron Monument SE 20" Oak 43.35' NW Tel. Pole 39.60' NE 8" Catalpa 42.60'

B. Description of corner evidence found and/or method applied in restoring or reestablishing corner.

K-6 Found Cast Iron Monument Found Nail & Tag in SW side of 28" Oak Found Nail & Tag in SW side of 28" Oak Centerline sign post Scar in face 20" Oak NE corner conc. block building found	S33E 44.15' S33E 43.98' SE 33.27' SE 43.31' SW 98.91'
--	---


P.A. 345 OTTAWA COUNTY
PEER APPROVED 11/21/94

Kendry D. Newbold

This marker is accepted as a careful and faithful perpetuation of the original corner.

C. Description of monument for corner and accessories established to perpetuate locating the position of the corner.

K-6 Cast Iron Monument (2'± E of N-S road, 6'± N of E-W road) Set O.C. Remon Nail & Tag in S side 16" Oak Set O.C. Remon Nail & Tag in NWly side 12" Maple Set O.C. Remon Nail & Tag in SEly side 14" Maple Centerline sign post NE corner conc. block building found	N85E 92.0' S42W 80.66' S73W 82.90' SE 33.27' SW 98.91'
--	--

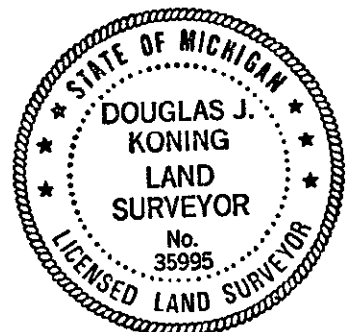

Signed by Douglas J. Koning
Surveyor's Michigan License No. 35995

Date November 14, 1994