

SURVEY & REMONUMENTATION

APR 24 1995

OTTAWA COUNTY REMONUMENTATION

RECORDED

COMMISSION

LAND CORNER RECORDATION CERTIFICATE

For corners in

Filing Requirement of Act 74, Mich. P.A. 1970

94 DEC 15 AM 11:48

Richard R. Hartman
REGISTER OF DEEDS
OTTAWA COUNTY, MI

Ottawa (County)	Located in:	Corner Code #
1. Public Land Survey	T 6N R 15W	K-9
	T R	(NW Cor., Sec.
	T R	25, Olive Twp.)
	T R	
2. Property Controlling in Section	S T R	
	S T R	
3. Miscellaneous Property in Sec.	S T R	
	S T R	

Register of Deeds Stamp & File Number

- 4. Lot No. _____, Recorded Plat _____
- 5. Private Claims _____

	A	B	C	D	E	F	G	H	I	J	K	L	M
2	6	5	4	3	2	1							
3													
4	7	8	9	10	11	12							
5													
6	18	17	16	15	14	13							
7													
8	19	20	21	22	23	24							
9													
10	30	29	28	27	26	25							
11													
12	31	32	33	34	35	36							
13													

I, Douglas J. Koning, in a field survey on November 18, 1994, do hereby certify that under requirements of P.A. 74, Michigan P.A. of 1970, the corner points mentioned in lines 1 and 2 above were in conformance with regulations and rules therefore as required in the current manual of survey instructions of the United States Department of the Interior, Bureau of Land Management or by a decree of a Court of Law and/or that the corner points mentioned in lines 3, 4 and 5 above were in conformance with the rules of the Michigan Board of Land Surveyors or by a Decree of a Court of Law; established, re-established, monumented, re-monumented, recovered, found as expressed below:

NOTE: Not more than 4 corners, all in the same town and range, may be recorded on this certificate.

A. Description of original monument and accessories and/or subsequent restoration:

K-9 Government Notes Set Post May 1832 By Calvin Britain, D.S. Pine 8" N39°W 16 Links Leo 10" S31°E 32 Links	L.C.R.C. Liber 1, Page 763, November 1972 K-9 Found Iron in Mon. Box Nail in Tel. Pole NW 51.12' Nail in 24" Oak NE 28.15' Nail in 28" Oak SE 42.22' NW Corner Bridge Pillar SE 20.14' SW Corner Bridge Pillar NE 19.55'	L.C.R.C. Liber 5, Page 322, August 1988 K-9 Found 3/8" Bar over plow point and Stone. Set cast iron mon. P. Pole SE 74.8' 26" Oak ESE 98.1' 8" Maple Clump WSW 130.65'
--	--	--

B. Description of corner evidence found and/or method applied in restoring or reestablishing corner.


K-9 Found Cast Iron Monument in Mon. Box	
Found Nail in SWly side Power Pole	S35°E 74.46'
Found Nail in N side 32" Oak	S70°E 98.4'± 0.2'
Found Nail in N side 10" Maple Clump	S75°W 130.61'

P.A. 345 OTTAWA COUNTY
PEER APPROVED 12/12/94
Richard P. Medowald

This marker is accepted as a careful and faithful perpetuation of the original corner.

C. Description of monument for corner and accessories established to perpetuate locating the position of the corner.

K-9 Cast Iron Monument (0.5' S of Centerline E-W Rd, 8'± E of Centerline Rd to S, 9'± E of Centerline Rd to N)	
Set O.C. Remon Nail & Tag in SWly side Power Pole	S35°E 74.74'
Set O.C. Remon Nail & Tag in N side 32" Oak	S70°E 98.66'
Set O.C. Remon Nail & Tag in Wly side Power Pole	N20°E 150.52'
Set O.C. Remon Nail & Tag in N side 10" Maple Clump	S75°W 130.40'

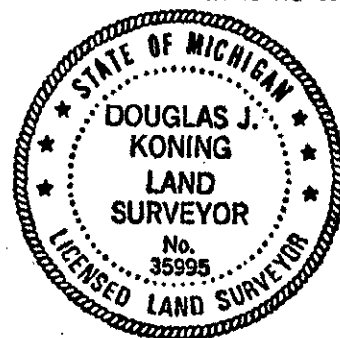

Signed by Douglas J. Koning
Surveyor's Michigan License No. 35995

Date November 21, 1994