

**SURVEY & REMONUMENTATION**

**OTTAWA COUNTT REMONUMENTATION**

**RECORDED**

**APR 24 1995**

**LAND CORNER RECORDATION CERTIFICATE**


Filing Requirement of Act 74, Mich. P.A. 1970 94 DEC 15 AM 11:48

For corners in **COMMISSION**

*Reginald C. Callman*  
REGISTER OF DEEDS  
OTTAWA COUNTY, MI

Ottawa (County)	Located in:	Corner Code #
1. Public Land Survey	T 6N R 15W	K-11
	T _____ R _____	(SW Cor., Sec.
	T _____ R _____	25, Olive Twp.)
	T _____ R _____	_____
2. Property Controlling in Section	S _____ T _____ R _____	_____
	S _____ T _____ R _____	_____
3. Miscellaneous Property in Sec.	S _____ T _____ R _____	_____
	S _____ T _____ R _____	_____
4. Lot No. _____, Recorded Plat _____		
5. Private Claims _____		

Register of Deeds Stamp & File Number

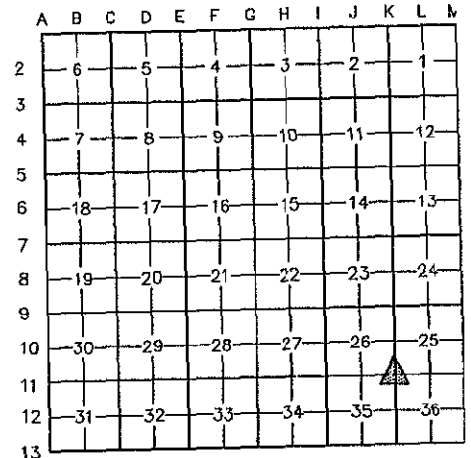

I, Douglas J. Koning, In a field survey on October 21, 1994, do hereby certify that under requirements of P.A. 74, Michigan P.A. of 1970, the corner points mentioned in lines 1 and 2 above were in conformance with regulations and rules therefore as required in the current manual of survey instructions of the United States Department of the Interior, Bureau of Land Management or by a decree of a Court of Law and/or that the corner points mentioned in lines 3,4 and 5 above were in conformance with the rules of the Michigan Board of Land Surveyors or by a Decree of a Court of Law; established, re-established, monumented, re-monumented, recovered, found as expressed below:

**NOTE: Not more than 4 corners, all in the same town and range, may be recorded on this certificate.**

**A. Description of original monument and accessories and/of subsequent restoration:**

K-11 Government Notes Set Post May 1832 By Calvin Britain, D.S. Hemlock 6" S45°E 11 Links Leo 10" N43°W 6 Links	L.C.R.C. Liber 1, Page 355 April 1972 K-11 Found Iron Nail in face of Trans Pole SW 55.0' Nail in face of 36" Elm SW 96.0' Nail in face of Tel. Pole NE 43.2' Nail in face of Pwr. Pole NE 62.0' Nail in face of 8" Wh. Oak NE 75.0' Street Sign SE 30.0'	L.C.R.C. Liber 3, Page 214 November 1977 K-11 Set cast iron monumnet Pwr. Pole NE 40.7' Centerline Street Sign SE 38.7' Pwr. Pole SE 71.38'
---	--	---

**B. Description of corner evidence found and/or method applied in restoring or reestablishing corner.**


K-11 Found Cast Iron Monument (Top Broke)		
Found Nail & Tag in face of Pwr. Pole	N54°E	40.52'
Found Nail & Tag SWly Side Pwr. Pole	S28°E	71.24'
Found Nail & Tag in face of 6" WoodPost	S48°W	41.91'

**P.A. 345 OTTAWA COUNTY**  
**PEER APPROVED**  
*Michael D. [Signature]*

This marker is accepted as a careful and faithful perpetuation of the original corner.

**C. Description of monument for corner and accessories established to perpetuate locating the position of the corner.**

K-11 Cast Iron Monumnet (on Centerline of Road to N., 2'± S of Centerline E-W Road)		
Set O.C. Remon Nail & Tag NW side Pwr. Pole	N54°E	40.75'
Set O.C. Remon Nail & Tag Wly side Pwr. Pole	S28°E	71.24'
Set O.C. Remon Nail & Tag SEly side 6" Woodpost	S48°W	42.15'
Centerline Stop Sign	N67°E	41.40'
Centerline Street Sign	S43°E	48.38'

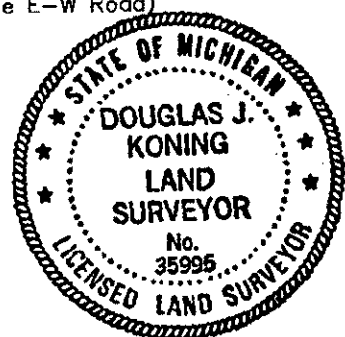

Signed by Douglas J. Koning  
Surveyor's Michigan License No. 35995

Date November 14, 1994