

SURVEY & REMONUMENTATION

APR 24 1995

OTTAWA COUNTY REMONUMENTATION LAND CORNER RECORDATION CERTIFICATE

RECORDED

COMMISSION

For corners in

Filing Requirement of Act 74, Mich. P.A. 1970

94 DEC 15 AM 11:48

Ottawa <small>(County)</small>	Located in:	Corner Code #	
1. Public Land Survey	T 6N R 15W	K-12	
	T _____ R _____	(W 1/4 cor., Sec.	
	T _____ R _____	36, Olive Twp.)	
	T _____ R _____	_____	
2. Property Controlling in Section	S _____ T _____ R _____	_____	
	S _____ T _____ R _____	_____	
3. Miscellaneous Property in Sec.	S _____ T _____ R _____	_____	
	S _____ T _____ R _____	_____	
4. Lot No. _____, Recorded Plat _____			
5. Private Claims _____			

Phyllis Callahan
REGISTER OF DEEDS
OTTAWA COUNTY, MI

Register of Deeds Stamp & File Number

	A	B	C	D	E	F	G	H	I	J	K	L	M
2	6	5	4	3	2	1							
3													
4	7	8	9	10	11	12							
5													
6	18	17	16	15	14	13							
7													
8	19	20	21	22	23	24							
9													
10	30	29	28	27	26	25							
11													
12	31	32	33	34	35	36							
13													

I, Douglas J. Koning, in a field survey on October 21, 1994, do hereby certify that under requirements of P.A. 74, Michigan P.A. of 1970, the corner points mentioned in lines 1 and 2 above were in conformance with regulations and rules therefore as required in the current manual of survey instructions of the United States Department of the Interior, Bureau of Land Management or by a decree of a Court of Law and/or that the corner points mentioned in lines 3, 4 and 5 above were in conformance with the rules of the Michigan Board of Land Surveyors or by a Decree of a Court of Law; established, re-established, monumented, re-monumented, recovered, found as expressed below:

NOTE: Not more than 4 corners, all in the same town and range, may be recorded on this certificate.

A. Description of original monument and accessories and/of subsequent restoration:

K-12 Government Notes Set Post May 1832 By Calvin Britain, D.S. Hemlock 4" N62°W 9 Links Leo 5" S62°E 14 Links	L.C.R.C. Liber 2, Page 225 June 1973 K-12 Set Cast Iron Monument Midway between NE & SE Sec. corners, but not on line 30" Oak WSW 62.50' Pwr. Pole ENE 67.95' Tel. Pole SE 51.41' Centerline Street Sign SW 19.83'
--	--

B. Description of corner evidence found and/or method applied in restoring or reestablishing corner.

K-12 Found Cast Iron Monument
Found Nail & Tag in face of Pwr Pole N69°E 67.9'
Midway between NE cor. & SW cor. Sec. 35, T5N, R16W, But not on line.


P.A. 345 OTTAWA COUNTY
PEER APPROVED 12/12/94

Douglas J. Koning

This marker is accepted as a careful and faithful perpetuation of the original corner.

C. Description of monument for corner and accessories established to perpetuate locating the position of the corner.

K-12 Cast Iron Monument (in centerline N-S road, 2' N of road to E)	
Set O.C. Remon Nail & Tag in Sly side Pwr. pole	N69°E 68.30'
Set O.C. Remon Nail & Tag in Nly side 10" Oak	S81°E 149.63'
Set O.C. Remon Nail & Tag in Ely side 28" Oak	N7°W 181.78'
NE cor. Conc. Block Barn Foundation	S65°W 216.42'
Centerline Street Sign	S62°W 19.84'

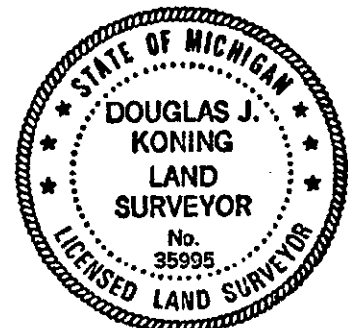

Signed by Douglas J. Koning
Surveyor's Michigan License No. 35995

Date November 14, 1994