

SURVEY & REMONUMENTATION

APR 25 1995

COMMISSION

OTTAWA COUNTY REMONUMENTATION LAND CORNER RECORDATION CERTIFICATE

RECORDED

94 DEC -8 PM 12:36

For corners in

Filing Requirement of Act 74, Mich. P.A. 1970

Daphne Williams
REGISTER OF DEEDS
OTTAWA COUNTY, MI

Ottawa (County)	Located in:	Corner Code #
1. Public Land Survey	T6N R15W	L-3
	T R	(N 1/4 cor., Sec.
	T R	12, Olive Twp.)
	T R	
2. Property Controlling in Section	S T R	
	S T R	
3. Miscellaneous Property in Sec.	S T R	
	S T R	
4. Lot No. _____, Recorded Plat _____		
5. Private Claims _____		

Register of Deeds Stamp & File Number

A	B	C	D	E	F	G	H	I	J	K	L	M
2	6	5	4	3	2	1						
3												
4	7	8	9	10	11	12						
5												
6	18	17	16	15	14	13						
7												
8	19	20	21	22	23	24						
9												
10	30	29	28	27	26	25						
11												
12	31	32	33	34	35	36						
13												

I, Douglas J. Koning, in a field survey on October 21, 1994 do hereby certify that under requirements of P.A. 74, Michigan P.A. of 1970, the corner points mentioned in lines 1 and 2 above were in conformance with regulations and rules therefore as required in the current manual of survey instructions of the United States Department of the Interior, Bureau of Land Management or by a decree of a Court of Law and/or that the corner points mentioned in lines 3, 4 and 5 above were in conformance with the rules of the Michigan Board of Land Surveyors or by a Decree of a Court of Law; established, re-established, monumented, re-monumented, recovered, found as expressed below:

NOTE: Not more than 4 corners, all in the same town and range, may be recorded on this certificate.

A. Description of original monument and accessories and/of subsequent restoration:

L-3 Government Notes Set Post May 1832 By Calvin Britain, D.S. Pine 12" S86°E 2.22 Links	L.C.R.C. Liber 3, Page 91 June 1976 L-3 Cast Iron Monument Tw 4" Apple E 45.28' 3" Boxelder E 49.72' Pwr. pole N10°W 38.07' Centerline Drain N 13.00' Centerline Pwr. line W 4.0'
---	---

B. Description of corner evidence found and/or method applied in restoring or reestablishing corner.

L-3 Found Cast Iron Monument
Found centerline drain N 10'±
Found centerline Pwr. line W 4'±
Found Nail & Tag E side Pwr. pole N10°W 37.85'


PA. 345 OTTAWA COUNTY
PEER APPROVED 11/21/94

Kendry D. Nedewell

This marker is accepted as a careful and faithful perpetuation of the original corner.

C. Description of monument for corner and accessories established to perpetuate locating the position of the corner.

L-3 Cast Iron Monument Set O.C. Remon Nail & Tag SWly side Pwr. pole Set O.C. Remon Nail & Tag W side Pwr. pole Set O.C. Remon Nail & Tag S side 30" TW Cottonwood Centerline drain Centerline Pwr. line	N10°W 37.64' S5°E 296.72' N90°W 189.69' N 10'± W 4'±
---	--

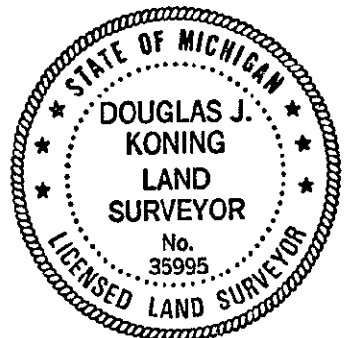

Signed by Douglas J. Koning
Surveyor's Michigan License No. 35995

Date November 14, 1994