

SURVEY & REMONUMENTATION

APR 24 1995

OTTAWA COUNTY REMONUMENTATION LAND CORNER RECORDATION CERTIFICATE

RECORDED

For corner **COMMISSION** Filing Requirement of Act 74, Mich. P.A. 1970

94 DEC 15 AM 11:48

Ottawa (County)	Located in:	Corner Code #
1. Public Land Survey	T 6N R 15W T _____ R _____ T _____ R _____ T _____ R _____	L-11 (N 1/4 cor., Sec. 36, Olive Twp.)
2. Property Controlling in Section	S _____ T _____ R _____ S _____ T _____ R _____	_____
3. Miscellaneous Property in Sec.	S _____ T _____ R _____ S _____ T _____ R _____	_____
4. Lot No. _____, Recorded Plat _____		
5. Private Claims _____		

Edyulis Hallman
REGISTER OF DEEDS
OTTAWA COUNTY, MI

Register of Deeds Stamp & File Number

	A	B	C	D	E	F	G	H	I	J	K	L	M
2	6	5	4	3	2								
3													
4	7	8	9	10	11	12							
5													
6	18	17	16	15	14	13							
7													
8	19	20	21	22	23	24							
9													
10	30	29	28	27	26	25							
11													
12	31	32	33	34	35	36							
13													

I, Douglas J. Koning, in a field survey on December 8, 1994, do hereby certify that under requirements of P.A. 74, Michigan P.A. of 1970, the corner points mentioned in lines 1 and 2 above were in conformance with regulations and rules therefore as required in the current manual of survey instructions of the United States Department of the Interior, Bureau of Land Management or by a decree of a Court of Law and/or that the corner points mentioned in lines 3, 4 and 5 above were in conformance with the rules of the Michigan Board of Land Surveyors or by a Decree of a Court of Law; established, re-established, monumented, re-monumented, recovered, found as expressed below:

NOTE: Not more than 4 corners, all in the same town and range, may be recorded on this certificate.

A. Description of original monument and accessories and/or subsequent restoration:

L-11 Government Notes Set Post May 1832 By Calvin Britian D.S. Tamarack 6" N48°E 98 Links Leo 8" S24°W 102 Links	L.C.R.C. Liber 1, Page 355 April 1972 L-11 Found Bent Iron Set Steel Bar Twin 24" Poplar S 90.45' 30" Maple NW 37.01' Pwr. pole NW 59.35'	L.C.R.C. Liber 3, Page 214 November 1977 L-11 Set Cast Iron Monument 30" Maple WNW 38.65' Pwr. pole NW 59.8' Twin 20" Poplar S 91.4'
--	---	--

B. Description of corner evidence found and/or method applied in restoring or reestablishing corner.

L-11
Centerline 30" Stump WNW 38.65'
Nail & Tag NE side Pwr. pole NW 59.77'


P.A. 345 OTTAWA COUNTY
PEER APPROVED 12/12/94

Harold D. Medwell

This marker is accepted as a careful and faithful perpetuation of the original corner.

C. Description of monument for corner and accessories established to perpetuate locating the position of the corner.

L-11 Cast Iron Monument (1' N of Centerline Road, 17' W. of Road Culvert)
Set O.C. Remon Nail & Tag NE side Pwr. pole N50°W 59.77'
Set O.C. Remon Nail & Tag W. side Pwr. pole N45°E 52.50'
Set O.C. Remon Nail & Tag E. side Twin 30" Cottonwood S 91.39'
Set O.C. Remon Nail & Tag N. side Tel pole S70°E 106.20'

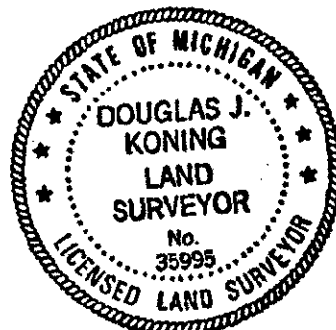

Signed by Douglas J. Koning
Surveyor's Michigan License No. 35995

Date December 12, 1994