

SURVEY & REMONUMENTATION

APR 24 1995

OTTAWA COUNTY REMONUMENTATION LAND CORNER RECORDATION CERTIFICATE

RECORDED

COMMISSION

For corners in

Filing Requirement of Act 74, Mich. P.A. 1970 94 DEC 15 AM 11:45

Ottawa (County)	Located in:	Corner Code #	
1. Public Land Survey	T <u>6N</u> R <u>15W</u>	<u>M-3</u>	
	T _____ R _____	(NE Cor., Sec.	
	T _____ R _____	<u>12, Olive Twp.)</u>	
	T _____ R _____	_____	
2. Property Controlling in Section	S _____ T _____ R _____	_____	
	S _____ T _____ R _____	_____	
3. Miscellaneous Property in Sec.	S _____ T _____ R _____	_____	
	S _____ T _____ R _____	_____	
4. Lot No. _____, Recorded Plat _____			
5. Private Claims _____			

Richard R. Kellerman
REGISTER OF DEEDS
OTTAWA COUNTY, MI

Register of Deeds Stamp & File Number

I, Douglas J. Koning, in a field survey on December 9, 1994, do hereby certify that under requirements of P.A. 74, Michigan P.A. of 1970, the corner points mentioned in lines 1 and 2 above were in conformance with regulations and rules therefore as required in the current manual of survey instructions of the United States Department of the Interior, Bureau of Land Management or by a decree of a Court of Law and/or that the corner points mentioned in lines 3, 4 and 5 above were in conformance with the rules of the Michigan Board of Land Surveyors or by a Decree of a Court of Law; established, re-established, monumented, re-monumented, recovered, found as expressed below:

NOTE: Not more than 4 corners, all in the same town and range, may be recorded on this certificate.

	A	B	C	D	E	F	G	H	I	J	K	L	M
2	6	5	4	3	2	1							
3													
4	7	8	9	10	11	12							
5													
6	18	17	16	15	14	13							
7													
8	19	20	21	22	23	24							
9													
10	30	29	28	27	26	25							
11													
12	31	32	33	34	35	36							
13													

A. Description of original monument and accessories and/or subsequent restoration:

M-3 Government Notes Set Post 1832 By Lucius Lyon D.S. Sylvester Sibley Red Oak 10" S22°W 16 Links Pine 8" N35°W 40 Links	L.C.R.C. Liber 3, Page 92 June 1976 M-3 R.R. Spike 18" Walnut Blendon Twp. cor. SE House cor. Tel. pole Centerline pvmt	L.C.R.C. Liber 4, Page 84 July 1980 M-3 Set Cast Iron Monument inscribed "Sec. Cor." 22" Walnut Tel. pole Tel. pole Blendon Twp. Cor. N
	W 57.66' N 78.58' NW 152.83' NW 76.60' W 3.10'	W 56.61' NW 75.28' NE 64.46' N 78.62'

B. Description of corner evidence found and/or method applied in restoring or reestablishing corner.


M-3 Found Cast Iron Monument in Mon. Box
 ☉ 28" stump W 57.5'
 Tel. pole (cut off) PK E side NW 75.17'
 C.I.M. N 78.65'

P.A. 345 OTTAWA COUNTY
 PEER APPROVED 12/12/94
Richard D. Hedewald

This marker is accepted as a careful and faithful perpetuation of the original corner.

C. Description of monument for corner and accessories established to perpetuate locating the position of the corner.

M-3 Cast Iron Monument in Mon. Box (3'± E of Centerlin of Road N-S)
 Set O.C. Remon Nail & Tag in W side pole N20°E 113.65'
 Set O.C. Remon Nail & Tag in SW side 15" Oak N35°W 104.34'
 Set O.C. Remon Nail & Tag in S side Pwr. pole N85°E 166.95'
 SE Cor. Conc. Block House Fndn. #8805 96th Ave. N40°W 152.78'
 Cast Iron Mon. in Mon. Box N 78.65'
 Top Centerline Conc. Marker NE 4.46'

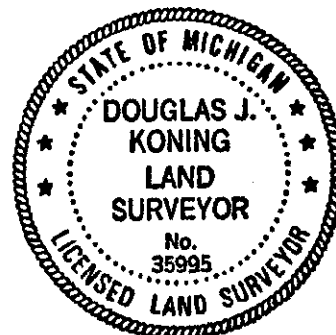

Signed by Douglas J. Koning
 Surveyor's Michigan License No. 35995

Date December 12, 1994