

SURVEY & REMONUMENTATION

APR 24 1995

**OTTAWA COUNTY REMONUMENTATION
LAND CORNER RECORDATION CERTIFICATE**

RECORDED

COMMISSION

For corners in

Filing Requirement of Act 74, Mich. P.A. 1970

94 DEC 15 AM 11:45

Phyllis Callahan
REGISTER OF DEEDS
OTTAWA COUNTY, MI

<u>Ottawa</u> (County)	Located in:	Corner Code #
1. Public Land Survey	T <u>6M</u> R <u>15W</u>	M-4
	T _____ R _____	(East 1/4 Cor.)
	T _____ R _____	Sec. 12, Olive Twp.)
	T _____ R _____	
2. Property Controlling in Section	S _____ T _____ R _____	
	S _____ T _____ R _____	
3. Miscellaneous Property in Sec.	S _____ T _____ R _____	
	S _____ T _____ R _____	
4. Lot No. _____, Recorded Plat _____		
5. Private Claims _____		

Register of Deeds Stamp & File Number

	A	B	C	D	E	F	G	H	I	J	K	L	M
2	6	5	4	3	2	1							
3													
4	7	8	9	10	11	12							
5													
6	18	17	16	15	14	13							
7													
8	19	20	21	22	23	24							
9													
10	30	29	28	27	26	25							
11													
12	31	32	33	34	35	36							
13													

I, Douglas J. Koning, in a field survey on December 9, 1994, do hereby certify that under requirements of P.A. 74, Michigan P.A. of 1970, the corner points mentioned in lines 1 and 2 above were in conformance with regulations and rules therefore as required in the current manual of survey instructions of the United States Department of the Interior, Bureau of Land Management or by a decree of a Court of Law and/or that the corner points mentioned in lines 3,4 and 5 above were in conformance with the rules of the Michigan Board of Land Surveyors or by a Decree of a Court of Law; established, re-established, monumented, re-monumented, recovered, found as expressed below:

NOTE: Not more than 4 corners, all in the same town and range, may be recorded on this certificate.

A. Description of original monument and accessories and/of subsequent restoration:

M-4 Government Notes	L.C.R.C. Liber 6, Page 167 October 1991
Set H.W. Post 1832	M-4 Set CIM
By Lucius Lyon D.S.	N to Blendon Cor. 80.63'
Sylvester Sibley	Tag NE side Pwr. pole NW 58.44'
Tamarack 5" S22°W 150 Links	Centerline Hydrant SW 76.47'
Leo 4" N4°W 351 Links	PK Nail top guard rail W 54.55'

B. Description of corner evidence found and/or method applied in restoring or reestablishing corner.


M-4 Found Cast Iron Monument in Mon. Box	
C.I.M.	N 80.62'
Found Nail NE side Pwr. pole	NW 58.48'
Centerline Hydrant	SW 76.46'

P.A. 345 OTTAWA COUNTY
PEER APPROVED 12/12/94
Madison D. Nedwell

This marker is accepted as a careful and faithful perpetuation of the original corner.

C. Description of monument for corner and accessories established to perpetuate locating the position of the corner.

M-4 Cast Iron Monument in Mon. Box (10'± E of Centerline)	
Set O.C. Remon Nail & Tag in NE side Pwr. pole	N55°W 58.48'
Set O.C. Remon Nail & Tag N. side pole	S80°W 243.63'
Top Centerline hydrant	S40°W 76.46'
Cast Iron Monument in Box	N 80.62'

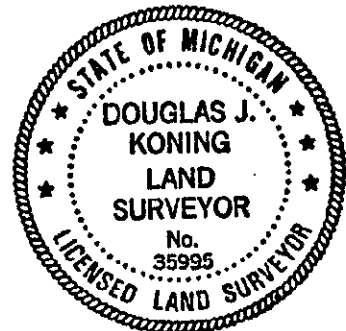

Signed by Douglas J. Koning
Surveyor's Michigan License No. 35995

Date December 12, 1994