

SURVEY & REMONUMENTATION

APR 24 1995

OTTAWA COUNTY REMONUMENTATION

RECORDED

COMMISSION

LAND CORNER RECORDATION CERTIFICATE

For corners in

Filing Requirement of Act 74, Mich. P.A. 1970

94 DEC 15 AM 11:45

Register of Deeds Stamp & File Number

Table with columns: Ottawa (County), Located in, Corner Code #. Rows include Public Land Survey, Property Controlling in Section, Miscellaneous Property in Sec., Lot No., and Private Claims.

Register of Deeds Stamp & File Number

Grid table with columns A-M and rows 2-13. Contains numerical values for each cell, likely representing a survey grid.

I, Douglas J. Koning, In a field survey on December 9, 1994, do hereby certify that under requirements of P.A. 74, Michigan P.A. of 1970, the corner points mentioned in lines 1 and 2 above were in conformance with regulations and rules therefore as required in the current manual of survey instructions of the United States Department of the Interior, Bureau of Land Management or by a decree of a Court of Law and/or that the corner points mentioned in lines 3, 4 and 5 above were in conformance with the rules of the Michigan Board of Land Surveyors or by a Decree of a Court of Law; established, re-established, monumented, re-monumented, recovered, found as expressed below:

NOTE: Not more than 4 corners, all in the same town and range, may be recorded on this certificate.

A. Description of original monument and accessories and/of subsequent restoration:

Table listing descriptions of monuments and accessories, including M-5 Government Notes, L.C.R.C. Liber 2, L.C.R.C. Liber 3, L.C.R.C. Liber 6, and various survey points and distances.

B. Description of corner evidence found and/or method applied in restoring or reestablishing corner.


Table listing descriptions of corner evidence found, including M-5 Found Cast Iron Monument in Box, Found Nail N side guard post, Found PK Nail NE side Pwr. pole, Found PK Nail NE side Light pole, C.I.M., Found Nail & Tag S side Pwr. pole, Found Nail & Tag N side Pwr. pole, and Found Nail & Tag N side R.R. Post.

P.A. 345 OTTAWA COUNTY PEER APPROVED 12/12/94 [Signature]

This marker is accepted as a careful and faithful perpetuation of the original corner.

C. Description of monument for corner and accessories established to perpetuate locating the position of the corner.

Table listing descriptions of monuments for corner and accessories, including M-5 Cast Iron Monument in Mon. Box (11'± E of Centerline) and various O.C. Remon Nail & Tag in NE side Pwr. pole, NE side Lt. pole, S. side Pwr. pole, N. side Gd. rail post, and N side Pwr. pole.

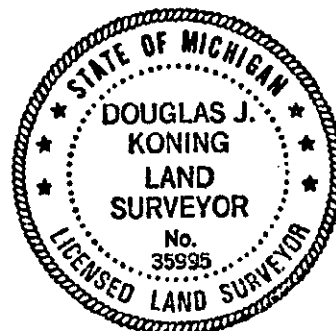

Signed by Douglas J. Koning Surveyor's Michigan License No. 35995

Date December 12, 1994