

APR 24 1995

COMMISSION

OTTAWA COUNTY REMONUMENTATION LAND CORNER RECORDATION CERTIFICATE

RECORDED

For corners in

Filing Requirement of Act 74, Mich. P.A. 1970

94 DEC 15 AM 11:45

<u>Ottawa</u> (County)	Located in:	Corner Code #
1. Public Land Survey	T 6N R 15W	M-6
	T _____ R _____	(E 1/4 Cor., Sec.
	T _____ R _____	13, Olive Twp.)
	T _____ R _____	_____
2. Property Controlling in Section	S _____ T _____ R _____	_____
	S _____ T _____ R _____	_____
3. Miscellaneous Property in Sec.	S _____ T _____ R _____	_____
	S _____ T _____ R _____	_____
4. Lot No. _____, Recorded Plat _____		
5. Private Claims _____		

D. J. Koning
REGISTER OF DEEDS
OTTAWA COUNTY, MI

Register of Deeds Stamp & File Number

I, Douglas J. Koning, in a field survey on December 9, 1994, do hereby certify that under requirements of P.A. 74, Michigan P.A. of 1970, the corner points mentioned in lines 1 and 2 above were in conformance with regulations and rules therefore as required in the current manual of survey instructions of the United States Department of the Interior, Bureau of Land Management or by a decree of a Court of Law and/or that the corner points mentioned in lines 3, 4 and 5 above were in conformance with the rules of the Michigan Board of Land Surveyors or by a Decree of a Court of Law; established, re-established, monumented, re-monumented, recovered, found as expressed below:

	A	B	C	D	E	F	G	H	I	J	K	L	M
2	6	5	4	3	2	1							
3													
4	7	8	9	10	11	12							
5													
6	18	17	16	15	14	13							
7													
8	19	20	21	22	23	24							
9													
10	30	29	28	27	26	25							
11													
12	31	32	33	34	35	36							
13													

NOTE: Not more than 4 corners, all in the same town and range, may be recorded on this certificate.

A. Description of original monument and accessories and/of subsequent restoration:

M-6 Government Notes Set H.W. Post 1832 By Lucius Lyon D.S. Sylvester Sibley Tamarack 4" S15°W 74 Links Leo 5" N60°W 44 Links	L.C.R.C. Liber 1, Page 95 October 1971 M-6 Found angle iron SE Cor. Att. Gar. Hse. # 7651 NW 157.75' NW Cor. Hse. # 7592 E 73.45' SW Cor. Att. Gar. Hse #7592 SE 104.40' Nail in face of Pwr. pole SW 61.93'	L.C.R.C. Liber 3, Page 351 June 1979 M-6 Found Angle iron NW-SE Cor. Gar. 157.75' SW Pwr. pole 61.93' E-NW Cor. Hse. #7592 73.45'
	L.C.R.C. Liber 2, Page 707 November 1974 M-6 Found 3/4" pipe 5' E. Centerline N-S Road, 18' S. of Road to W. SW Cor. Bridge S60°E 20.28' SW Cor. Bridge S43°W 31.28' Tel. pole S40°W 61.98' 36" Ash N43°E 50.59'	L.C.R.C. Liber 6, Page 168 October 1991 M-6 Set Capped iron NW Cor. Brk. Hse. #7592 E 72.80' Nail & Tag 30" Cottonwood ENE 36.92' PK Nail in Pwr. pole WSW 65.74' Blendon Corner N 72.87'

B. Description of corner evidence found and/or method applied in restoring or reestablishing corner.


M-6 Found capped iron in box
NW Cor. Brk. Hse. #7592 E 72.77'
Found Nail & Tag 30" Cottonwood ENE 36.88'
Found Blendon Corner N 72.85'

P.A. 345 OTTAWA COUNTY
PEER APPROVED 12/12/94
Wendy D. Peterson

This marker is accepted as a careful and faithful perpetuation of the original corner.

C. Description of monument for corner and accessories established to perpetuate locating the position of the corner.

M-6 Set form PIN and O.C.R. cap (5'± E of Centerline, 15' S of Centerline)
Set O.C. Remon Nail & Tag in SE side 36" Cottonwood N65°E 36.84'
Set O.C. Remon Nail & Tag in Nly side Pwr. pole S70°W 67.97'
Cast Iron Mon. in Mon. Box N 72.85'
NW cor. Brick House #7592 E 72.77'
SE cor. #7615 N55°W 157.99'

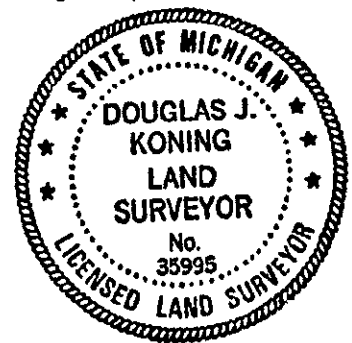

Signed by Douglas J. Koning
Surveyor's Michigan License No. 35995

Date December 12, 1994