

SURVEY & REMONUMENTATION

APR 24 1995

COMMISSION

**OTTAWA COUNTY REMONUMENTATION
LAND CORNER RECORDATION CERTIFICATE**

RECORDED

For corners in

Filing Requirement of Act 74, Mich. P.A. 1970 DEC 15 AM 11:48

Ottawa (County)	Located in:	Corner Code #
1. Public Land Survey	T 6N R15W	M-10
	T R	(E. 1/4 cor., Sec.
	T R	25, Olive Twp.)
	T R	
2. Property Controlling in Section	S T R	
	S T R	
3. Miscellaneous Property in Sec.	S T R	
	S T R	
4. Lot No. _____, Recorded Plat _____		
5. Private Claims _____		

Dorothy Redman
REGISTER OF DEEDS
OTTAWA COUNTY, MI

Register of Deeds Stamp & File Number

	A	B	C	D	E	F	G	H	I	J	K	L	M
2	6	5	4	3	2	1							
3													
4	7	8	9	10	11	12							
5													
6	18	17	16	15	14	13							
7													
8	19	20	21	22	23	24							
9													
10	30	29	28	27	26	25							
11													
12	31	32	33	34	35	36							
13													

I, Douglas J. Koning, in a field survey on December 8, 1994, do hereby certify that under requirements of P.A. 74, Michigan P.A. of 1970, the corner points mentioned in lines 1 and 2 above were in conformance with regulations and rules therefore as required in the current manual of survey instructions of the United States Department of the Interior, Bureau of Land Management or by a decree of a Court of Law and/or that the corner points mentioned in lines 3,4 and 5 above were in conformance with the rules of the Michigan Board of Land Surveyors or by a Decree of a Court of Law; established, re-established, monumented, re-monumented, recovered, found as expressed below:

NOTE: Not more than 4 corners, all in the same town and range, may be recorded on this certificate.

A. Description of original monument and accessories and/of subsequent restoration:

M-10 Government Notes Set Post 1832	L.C.R.C. Liber 1, Page 241 January 1972	L.C.R.C. Liber 3, Page 162 April 1977
By Lucius Lyon D.S. Sylvester Sibley	M-10 Found "X" in concrete Brass plug N 64.48' C. P. Pole ESE 55.95'	M-10 1" square bolthead Pwr. pole S60°E 55.93' Tel. pole S77°W 80.87' St. sign N28°W 45.77' 6" Maple S34°W 92.76'
Hemlock 7 corner tree	L.C.R.C. Liber 1, Page 355 April 1972	L.C.R.C. Liber 6, Page 9 October 1989
	M-10 Found cross Nail in face of Tel. pole NW 44.68' Nail in face of Tel. pole SW 80.35' Nail in face of Pwr. pole SE 55.90' Brass plug N 64.48' Street sign NW 46.45'	M-10 Set CIM Nail S side Pwr. pole S70°E 56.55' Nail E side 32" Maple N25°E 99.75' Nail SE side clump 6-10" Oak S30°W 93.98' Nail S side Tel. pole S70°W 80.68' West 1/4 cor., Sec. 30-6-14 N 64.67'

B. Description of corner evidence found and/or method applied in restoring or reestablishing corner.

M-10 Set CIM
Found PK Nail NE side Pwr. pole S70°E 56.55'
Found Nail Se side clump 6-10" Oak S30°W 93.93'
Nail is S side cut off Tel. pole S70°W 80.68'
C.I.M. N 64.64'
Found Nail E. side 32" Maple N25°E 99.70'

P.A. 345 OTTAWA COUNTY


PEER APPROVED 12/12/94

Douglas J. Koning

This marker is accepted as a careful and faithful perpetuation of the original corner.

C. Description of monument for corner and accessories established to perpetuate locating the position of the corner.

M-10 Cast Iron Monument (in Centerline Road N,S,W)
O.C. Remon Nail & Tag S. side Pwr. pole S60°E 56.50'
O.C. Remon Nail & Tag N. side Pwr. pole S85°W 193.28'
O.C. Remon Nail & Tag W. side Pwr. pole N30°E 117.70'
O.C. Remon Nail & Tag NW side clump of Maples S30°W 93.04'
Top centerline hydrant NE 96.48'
C.I.M. N 64.64'

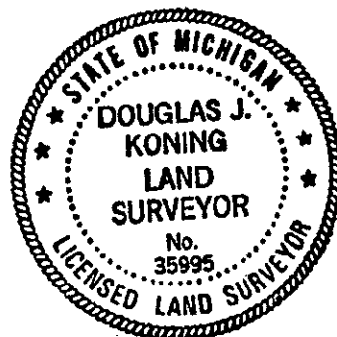

Signed by Douglas J. Koning
Surveyor's Michigan License No. 35995

Date December 12, 1994