

SURVEY & REMONUMENTATION

APR 24 1995

COMMISSION

* For corners in

**OTTAWA COUNTY REMONUMENTATION
LAND CORNER RECORDATION CERTIFICATE
Filing Requirement of Act 74, Mich. P.A. 1970**

RECORDED

94 DEC 15 AM 11:47


Ottawa (County)	Located in:	Corner Code #
1. Public Land Survey	T 6N R 15W	M-11
	T R	(NE Cor., Sec.
	T R	36, Olive Twp.)
	T R	
2. Property Controlling in Section	S T R	
	S T R	
3. Miscellaneous Property in Sec.	S T R	
	S T R	
4. Lot No. _____, Recorded Plat _____		
5. Private Claims _____		

Phyllis Carlsson
REGISTER OF DEEDS
OTTAWA COUNTY, MI

Register of Deeds Stamp & File Number

I, Douglas J. Koning, in a field survey on December 8, 19 94, do hereby certify that under requirements of P.A. 74, Michigan P.A. of 1970, the corner points mentioned in lines 1 and 2 above were in conformance with regulations and rules therefore as required in the current manual of survey instructions of the United States Department of the Interior, Bureau of Land Management or by a decree of a Court of Law and/or that the corner points mentioned in lines 3, 4 and 5 above were in conformance with the rules of the Michigan Board of Land Surveyors or by a Decree of a Court of Law; established, re-established, monumented, re-monumented, recovered, found as expressed below:

NOTE: Not more than 4 corners, all in the same town and range, may be recorded on this certificate.

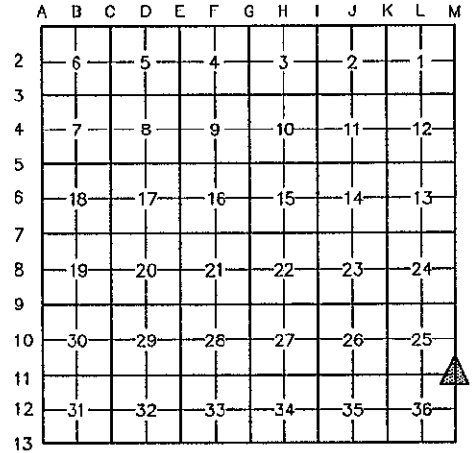

A. Description of original monument and accessories and/of subsequent restoration:

M-11 Government Notes Set Post 1832	L.C.R.C. Liber 1, Page 241 January 1972	L.C.R.C. Liber 6, Page 9 October 1989
By Lucius Lyon D.S. Sylvester Sibley	M-11 Found "X" in Concrete	M-11 Set CIM
Tamarack 6" S27°W 12 Links	Iron in pavement N 30.36'	Nail NE side Pwr. pole SE 69.27'
Leo 5" N20°W 85 Links	Pwr. pole NNW 81.60'	P.K. Nail SW side Tel. Pole NNW 81.85'
	L.C.R.C. Liber 1, Page 355 April 1972	P.K. Nail E. side Tel. pole SSW 71.62'
	M-11 Found cross set iron pipe	Centerline top of hydrant NE 43.76'
	Nail in face of Tel. pole SW 71.46'	SW cor., Sec. 30-6-14 N 30.41'
	Nail in face of Pwr. pole SE 68.81'	
	Nail in face of Tel. pole NW 81.54'	
	Street sign NW 45.33'	
	Iron pipe -Blendon Twp. N 30.34'	

B. Description of corner evidence found and/or method applied in restoring or reestablishing corner.

M-11 Found Cast Iron Monument in Mon. Box
Nail NE side Pwr. pole SE 69.23'
Centerline top of hydrant NE 43.74'
Cast Iron Monument N 30.45'

P.A. 345 OTTAWA COUNTY
PEER APPROVED 12/12/94
Wesley D. Hedwood

This marker is accepted as a careful and faithful perpetuation of the original corner.

C. Description of monument for corner and accessories established to perpetuate locating the position of the corner.

M-11 Cast Iron Monument in Box (in Centerline N-S Road, 6' S. of Centerline Road W.)	
O.C. Remon Nail & Tag in NE side Pwr. pole	S40°E 69.20'
O.C. Remon Nail & Tag in NE side Service pole	N20°W 226.45'
O.C. Remon Nail & Tag in SE side cor.fnc.post	N60°E 49.88'
SE cor. conc. block foundation house #	N50°W 178.66'
Top centerline hydrant	N55°E 43.74'
Cast iron monument in box	N 30.45'



Signed by Douglas J. Koning
Surveyor's Michigan License No. 35995

Date December 12, 1994