

FEB 24 2000

RECORDED

99 DEC -2 PM 1:12

SECTION

OTTAWA COUNTY REMONUMENTATION
LAND CORNER RECORDATION CERTIFICATE
Filing Requirement of Act 74, Mich. P.A. 1970

Dany Scholten
REGISTER OF DEEDS
OTTAWA COUNTY, MI

For corners in
OTTAWA
(County)

Located in:	Corner Code #
T 6N R 15W	C-8, W 1/4 corner
T R	Section 20, Olive
T R	Township
T R	
S T R	
S T R	
S T R	
S T R	

Seg-2

Register of Deeds Stamp & File Number

4. Lot No. _____, Recorded Plat _____
5. Private Claims _____

Randal J. Vuoteveen, in a field survey on October 6, 1999 do hereby state that under requirements of P.A. 74, Michigan P.A. of 1970, the corner points mentioned in lines 1 and 2 above were in conformance with regulations and rules therefore as required in the current manual of survey instructions of the United States Department of the Interior, Bureau of Land Management or by a decree of a Court of Law and /or that the corner points mentioned in lines 3, 4 and 5 above were in conformance with the rules of the Michigan Board of Land Surveyors or by a Decree of a Court of Law, established, re-established, monumented, recovered, found as expressed below:

NOTE: Not more than 2 corners, all in the same town and range, may be recorded on this certificate.

A	B	C	D	E	F	G	H	I	J	K	L	M
1												
2	6	5	4	3	2	1						
3												
4	7	8	9	10	11	12						
5												
6	18	17	16	15	14	13						
7												
8	19	20	21	22	23	24						
9												
10	30	29	28	27	26	25						
11												
12	31	32	33	34	35	36						
13												

A. Description of original monument and accessories and/or subsequent restoration:

C-8 Peer Approved Corner Liber 1, Page 524
(Doug Koning November 21, 1994)
Cast Iron Monument (12" N of centerline "X" of roads)
Nail & Remon Tag SE side 12" Spruce N60°E 55.48'
Nail & Remon Tag SW side P. Pole S67°E 111.77'
Nail & Remon Tag N'y side Twin 16" Basswood S78°W 115.41'
NE corner brick house S43°W 144.50'

B. Description of corner evidence found and/or method applied in restoring or reestablishing corner:

C-8 Found Cast Iron Monument (12" Deep) 12 feet North of centerline "X"

NE corner brick house S43°W 144.61'
Center of Spruce Stump N59°E 55.3'


Accepted Cast Iron Monument as a careful and faithful perpetuation of the position of the original corner.

Set 3/4" X 0.7' Solid Bar with Ottawa County Remon Cap on top of Cast Iron Monument

C. Description of monument for corner and accessories established to perpetuate locating the position of the corner:

C-8 3/4" X 0.7' Solid Bar with Ottawa County Remon Cap on top of Cast Iron Monument

On centerline N & S road (To be paved week of October 11)
12' North of center gravel road E & W
Set Nail & Remon Tag in N side 22" Spruce N65°E 74.04'
Set Nail & Remon Tag in E side Power Pole S12°W 167.74'
Set Nail & Remon Tag in S side Power Pole S54°W 41.85'
Set Nail & Remon Tag in S side Power Pole N73°W 84.69'
NE corner brick house S43°W 144.61'

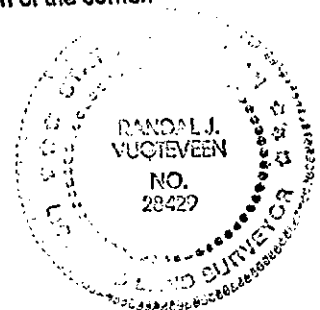

99.00 CORNER
Receipt #64945

Signed by *Randal J. Vuoteveen*
Surveyor's Michigan License No. 28429

Date OCTOBER 27, 1999