

CONVEY &  
REMONUMENTATION

APR 05 1996

COMMISSION OTTAWA COUNTY REMONUMENTATION  
LAND CORNER RECORDATION CERTIFICATE

RECORDED

For corners in Filing Requirement of Act 74, Mich. P.A. 1970

95 NOV 15 PM 2:08

Ottawa (County)	Located in:	Corner Code #
1. Public Land Survey	T 6N R 15W	I-7
	T R	(SE cor., Sec. 15
	T R	Olive Twp.)
	T R	
2. Property Controlling in Section	S T R	
	S T R	
3. Miscellaneous Property in Sec.	S T R	
	S T R	
4. Lot No. _____, Recorded Plat _____		
5. Private Claims _____		


*Dorothy Cullman*  
REGISTER OF DEEDS  
OTTAWA COUNTY, MI

*Sequence #2*

Register of Deeds Stamp & File Number

I, Douglas J. Koning, in a field survey on October 23, 1995, do hereby certify that under requirements of P.A. 74, Michigan P.A. of 1970, the corner points mentioned in lines 1 and 2 above were in conformance with regulations and rules therefore as required in the current manual of survey instructions of the United States Department of the Interior, Bureau of Land Management or by a decree of a Court of Law and/or that the corner points mentioned in lines 3,4 and 5 above were in conformance with the rules of the Michigan Board of Land Surveyors or by a Decree of a Court of Law; established, re-established, monumented, re-monumented, recovered, found as expressed below:

NOTE: Not more than 4 corners, all in the same town and range, may be recorded on this certificate.

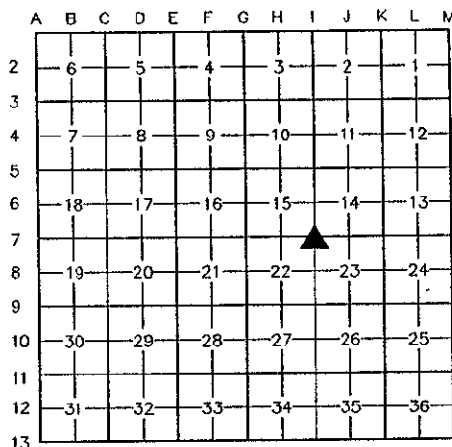

A. Description of original monument and accessories and/of subsequent restoration:

- I-7 Cast Iron Monument in Box (Centerline of Crossroads N, S, E, W)
- Nail and O.C. Remon Tag West side Triple Sycamore N14°W 110.65'
- Nail and O.C. Remon Tag NE side Power Pole N56°W 75.10'
- Nail and O.C. Remon Tag SE side 12" Pine S41°W 57.22'
- Nail and O.C. Remon Tag Sw side 54" Maple S52°E 36.58'

P.A. 345 OTTAWA COUNTY  
PEER APPROVED 10/23/95

*Kendry D. Redwood*  
907

B. Description of corner evidence found and/or method applied in restoring or reestablishing corner.

- I-7 Cast Iron Monument in Box (Centerline of Crossroads N, S, E, W)
- Nail and O.C. Remon Tag NE side Power Pole N56°W 75.10'
- Nail and O.C. Remon Tag SE side 12" Pine S41°W 57.22'
- Nail and O.C. Remon Tag Sw side 54" Maple S52°E 36.58'

This marker is accepted as a careful and faithful perpetuation of the original corner.

C. Description of monument for corner and accessories established to perpetuate locating the position of the corner.

- I-7 Cast Iron Monument in Box (Centerline of Crossroads N, S, E, W)
- Nail and O.C. Remon Tag NE side Power Pole N56°W 75.10'
- Nail and O.C. Remon Tag SE side 12" Pine S41°W 57.22'
- Nail and O.C. Remon Tag Sw side 54" Maple S52°E 36.58'
- Set O.C. Remon Tag and PK South end CMP S55°E 54.45'

Signed by Douglas J. Koning  
Surveyor's Michigan License No. 35995

Date 10-20-95

