

SURVEY & REMONUMENTATION

APR 05 1996

COMMISSION

OTTAWA COUNTY REMONUMENTATION LAND CORNER RECORDATION CERTIFICATE

Filing Requirement of Act 74, Mich. P.A. 1970

For corners in Ottawa Located In: _____ Corner Code # _____
 (County)

1. Public Land Survey T6N R16W F-3
 T _____ R _____ S 1/4 cor. Sec.
 T _____ R _____ 4, Port
 T _____ R _____ Sheldon Twp.

2. Property Controlling S _____ T _____ R _____
 in Section S _____ T _____ R _____

3. Miscellaneous S _____ T _____ R _____
 Property in Sec. S _____ T _____ R _____

RECORDED

95 NOV 15 PM 2: 14

Elizabeth Kallman
 REGISTER OF DEEDS
 OTTAWA COUNTY, MI

Register of Deeds Stamp & File Number

4. Lot No. _____ Recorded Plat _____
 5. Private Claims _____

I, Steven Lampen, in a field survey on October 12, 1995, do hereby certify that under requirements of P.A. 74, Michigan P.A. of 1970, the corner points mentioned in lines 1 and 2 above were in conformance with regulations and rules therefore as required in the current manual of survey instructions of the United States Department of the Interior, Bureau of Land Management or by a decree of a Court of Law and/or that the corner points mentioned in lines 3, 4 and 5 above were in conformance with the rules of the Michigan Board of Land Surveyors or by a Decree of a Court of Law; established, re-established, monumented, re-monumented, recovered, found as expressed below:

1	A	B	C	D	E	F	G	H	I	J	K	L	M
2	6	5	4	3	2	1							
3													
4	7	8	9	10	11	12							
5													
6	18	17	16	15	14	13							
7													
8	19	20	21	22	23	24							
9													
10	30	29	28	27	26	25							
11													
12	31	32	33	34	35	36							
13													

NOTE: Not more than 4 corners, all in the same town and range, may be recorded on this certificate.

A. Description of original monument and accessories and/or subsequent restoration:

F-3

GLO	LCRC L 1-P 791		
May 1832	Found concrete monument	LCRC L 5-P 254	
Surveyor - Calvin Britain	24" Maple SW 70.21'	Set CIM	
Set post	20" Oak NW 65.16'	15" Maple	SE 35.44'
12" Beech N 48° W 17'	20" Maple W 67.64'	12" Twin Oak	NE 41.00'
10" Beech S 32° W 11'		20" Oak	NW 65.95'
		24" Maple	SW 56.24'

B. Description of corner evidence found and/or method applied in restoring or reestablishing corner:

F-3
 Found CIM in monument box and is accepted as a careful and faithful perpetuation of the position of the original corner.

20" Oak NW 65.16'	15" Maple SE 35.44'
	12" Twin Oak NE 41.00'
	20" Oak NW 65.95'
	24" Maple SW 56.24'


P.A. 345 OTTAWA COUNTY
 PEER APPROVED 10/23/95

Robert P. Redwood
 RPN

C. Description of monument for corner and accessories established to perpetuate locating the position of the corner:

F-3
 CIM in monument Box

Recon. tag in SW side 26" Oak	AZ = MI State plane grid direction	303° 55'	66.14'
Recon. tag in NW side 28" Maple		226° 05'	56.23'
Recon. tag in SW side 12" Maple		135° 03'	51.12'
SW corner house foundation		48° 59'	107.80'
Recon. tag in NE side 8" Oak		127° 20'	69.52'

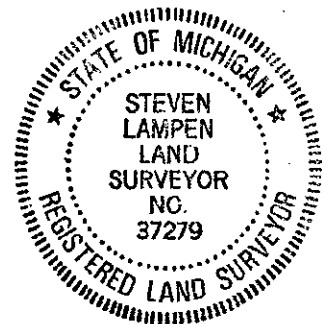

Signed by Steven Lampen

Date October 23, 1995

Surveyor's Michigan License No. 37279