

**SURVEY
REMONUMENTATION**

APR 24 1985

COMMISSION

**OTTAWA COUNTY REMONUMENTATION
LAND CORNER RECORDATION CERTIFICATE
Filing Requirement of Act 74, Mich. P.A. 1970**

RECORDED

94 DEC 14 AM 9:43

Robert D. ...
REGISTER OF DEEDS
OTTAWA COUNTY, MI


For corners in

<u>Ottawa</u> <small>(County)</small>	Located In:	Corner Code #
1. Public Land Survey	T <u>6N</u> R <u>16W</u>	<u>F-5 N1/4 Cor</u> <u>Sec 16</u> <u>Port Sheldon Twp.</u>
	T _____ R _____	_____
	T _____ R _____	_____
2. Property Controlling in Section	S _____ T _____ R _____	_____
	S _____ T _____ R _____	_____
3. Miscellaneous Property in Sec.	S _____ T _____ R _____	_____
	S _____ T _____ R _____	_____

Register of Deeds Stamp & File Number

4. Lot No. _____, Recorded Plat _____
5. Private Claims _____

I, John P. Clapp, in a field survey on December 3, 19 94, do hereby certify that under requirements of P.A. 74, Michigan P.A. of 1970, the corner points mentioned in lines 1 and 2 above were in conformance with regulations and rules therefore as required in the current manual of survey instructions of the United States Department of the Interior, Bureau of Land Management or by a decree of a Court of Law and/or that the corner points mentioned in lines 3, 4 and 5 above were in conformance with the rules of the Michigan Board of Land Surveyors or by a Decree of a Court of Law; established, re-established, monumented, re-monumented, recovered, found as expressed below:

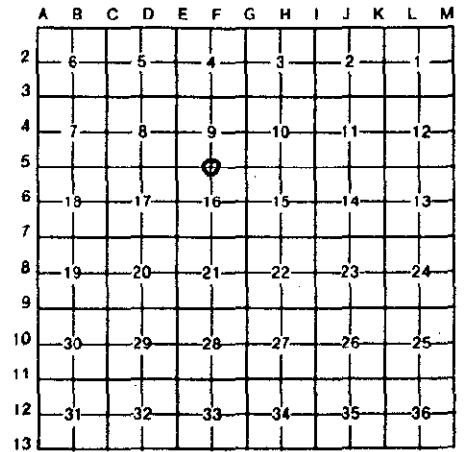

NOTE: Not more than 4 corners, all in the same town and range, may be recorded on this certificate.

A. Description of original monument and accessories and/or subsequent restoration:

F-5 Govt Land Office Survey Notes 1832-Surveyor, Calvin Britain Set 1/2 mile post 24" Hemlock N27°W 27 links 10" Hemlock S42°E 20 links	F-5 Recorded in Liber 2, Page 483, May 29, 1974 Found Steel Bar 6" Maple NW 39.81' 6" Cherry NE 57.20' 8" Tw Oak NE 64.75' Fence Post SE 49.96' Fence Post SW 53.03'	F-5 Recorded in Liber 5 Page 354, Dec. 6, 1988 Fd Steel bar, Set C.I.M. Power Pole WNW 66.45' Gate Post SSW 42.77' CL St Sign NE 32.58' Fence Post SE 74.38'
---	---	--

B. Description of corner evidence found and/or method applied in restoring or reestablishing corner:

P.A. 345 OTTAWA COUNTY
PEER APPROVED 12/12/94

F-5
Found cast iron monument flush with pavement and accepted it as a careful and faithful perpetuation of the position of the original corner

Found Nail & Tag in NE Side Power Pole	AZ 294°	66.63'
Face of Steel Gate Post	AZ 202°	42.63'
CL Street Sign	AZ. 48°	32.64'
Face of Corner Fence Post	AZ. 112°	74.36'


C. Description of monument for corner and accessories established to perpetuate locating the position of the corner:

F-5
Found Cast Iron Monument Flush with Pavement

O.C Remon Tag & Nail in SE Side 16" Pine	AZ	25°	149.17'
Face of Corner Fence Post	AZ.	112°	74.36'
Face of Steel Gate Post	AZ.	202°	42.63'
O.C. Remon Tag & Nail in NE Side 12" Cherry	AZ.	308°	83.92'

Signed by John P. Clapp Date Dec. 6, 1994

Surveyor's Michigan License No. 14091

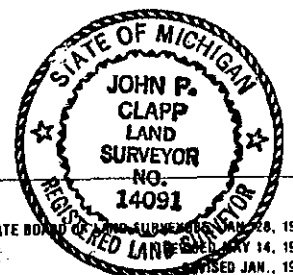

FORM APPROVED BY MICHIGAN STATE BOARD OF LAND SURVEYORS JAN. 28, 1971
REVISED JAN., 1983