

SURVEY & REMONUMENTATION

APR 05 1996

COMMISSION

**OTTAWA COUNTY REMONUMENTATION
LAND CORNER RECORDATION CERTIFICATE
Filing Requirement of Act 74, Mich. P.A. 1970**

For corners in
Ottawa (County) Located In: Corner Code #

1. Public Land Survey T6N R16W F-7
T R S 1/4 cor. Sec.
T R 16, Port
T R Sheldon Twp.

2. Property Controlling S T R
in Section S T R
3. Miscellaneous S T R
Property in Sec. S T R

RECORDED
95 NOV 15 PM 2:14
Rhonda Caldwell
REGISTER OF DEEDS
OTTAWA COUNTY, MI
Register of Deeds Stamp & File Number

4. Lot No. _____, Recorded Plat _____
5. Private Claims _____

I, Steven Lampen, in a field survey on October 12, 1995, do hereby certify that under requirements of P.A. 74, Michigan P.A. of 1970, the corner points mentioned in lines 1 and 2 above were in conformance with regulations and rules therefore as required in the current manual of survey instructions of the United States Department of the Interior, Bureau of Land Management or by a decree of a Court of Law and/or that the corner points mentioned in lines 3, 4 and 5 above were in conformance with the rules of the Michigan Board of Land Surveyors or by a Decree of a Court of Law; established, re-established, monumented, re-monumented, recovered, found as expressed below:

1	A	B	C	D	E	F	G	H	I	J	K	L	M
2	6	5	4	3	2	1							
3													
4	7	8	9	10	11	12							
5													
6	18	17	16	15	14	13							
7													
8	19	20	21	22	23	24							
9													
10	30	29	28	27	26	25							
11													
12	31	32	33	34	35	36							
13													

NOTE: Not more than 4 corners, all in the same town and range, may be recorded on this certificate.

A. Description of original monument and accessories and/or subsequent restoration:

F-7
GLO LCRS L 1-P 317
May 1832 1" solid iron
Calvin Britain Nail in side 12" Basswood E 1.37'
Set Post Nail in side 16" Basswood NW 3.29'
Hemlock 24 N27W 27 Nail in side 10" Basswood WNW 30.61'
Hemlock 10 S42E 20 Nail in side 20" Oak NE 33.79'
Nail in side 20" Oak ESE 34.11'

B. Description of corner evidence found and/or method applied in restoring or reestablishing corner:


F-7
Found 1" solid Iron and is accepted as a careful and faithful perpetuation of the position of the original corner.
Nail in side 12" Basswood E 1.37'
Nail in side 16" Basswood NW 3.29'
Nail in side 10" Basswood WNW 30.61'
Nail in side 20" Oak NE 33.79'
Nail in side 20" Oak ESE 34.11'

P.A. 345 OTTAWA COUNTY
PEER APPROVED 10/23/95

Richard D. McDowell
RD

C. Description of monument for corner and accessories established to perpetuate locating the position of the corner:

F-7
Set Remon Az = MI State Plane Grid Direction
Corner fits plats Port Sheldon Beach and 1st Addition to Port Sheldon Beach.
Remon Tag in NW side 26" Oak 61° 43' 33.99'
Remon Tag in NE side 10" Basswood 3° 06' 17.52'
Remon Tag in SW side 24" Oak 131° 07' 34.39'
Remon Tag in South side 24" Oak 261° 10' 34.16'
Remon Tag in NE side 16" Basswood 327° 17' 3.29'
Remon Tag in North side 12" Basswood 88° 25' 1.79'

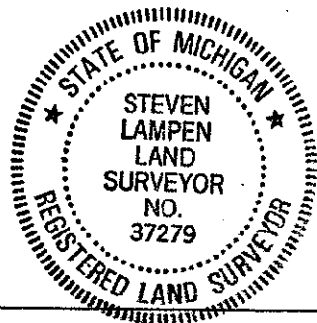

Signed by Steven Lampen Date October 23, 1995
Surveyor's Michigan License No. 37279

FORM APPROVED BY MICHIGAN STATE BOARD OF LAND SURVEYORS, JAN. 28, 1971
REVISED MAY 14, 1975
REVISED JAN., 1983
ADAPTED FOR WORD PROCESSING MARCH, 1993