

APR 05 1996

COMMISSION

OTTAWA COUNTY REMONUMENTATION
LAND CORNER RECORDATION CERTIFICATE
Filing Requirement of Act 74, Mich. P.A. 1970

For corners in
Ottawa _____
(County)

Located In: _____ Corner Code # _____

1. Public Land Survey T6N R16W F-11
T _____ R _____
S 1/4 cor. Sec.
T _____ R _____
28, Port
T _____ R _____
Sheldon Twp.

2. Property Controlling S _____ T _____ R _____
in Section S _____ T _____ R _____

3. Miscellaneous S _____ T _____ R _____
Property in Sec. S _____ T _____ R _____

RECORDED

95 NOV 15 PM 2: 14

Polycia S. Hallman
REGISTER OF DEEDS
OTTAWA COUNTY, MI

Register of Deeds Stamp & File Number

4. Lot No. _____, Recorded Plat _____
5. Private Claims _____

	A	B	C	D	E	F	G	H	I	J	K	L	M
1													
2	6	5	4	3	2	1							
3													
4	7	8	9	10	11	12							
5													
6	18	17	16	15	14	13							
7													
8	19	20	21	22	23	24							
9													
10	30	29	28	27	26	25							
11													
12	31	32	33	34	35	36							
13													

I, Steven Lamphen _____, in a field survey on October 12 1995 _____, do hereby certify that under requirements of P.A. 74, Michigan P.A. of 1970, the corner points mentioned in lines 1 and 2 above were in conformance with regulations and rules therefore as required in the current manual of survey instructions of the United States Department of the Interior, Bureau of Land Management or by a decree of a Court of Law and/or that the corner points mentioned in lines 3, 4 and 5 above were in conformance with the rules of the Michigan Board of Land Surveyors or by a Decree of a Court of Law; established, re-established, monumented, re-monumented, recovered, found as expressed below:

NOTE: Not more than 4 corners, all in the same town and range, may be recorded on this certificate.

A. Description of original monument and accessories and/or subsequent restoration:

F-11				LCRC L2-P301				LCRC L2-P485				LCRC L5-P137																				
GLO	May, 1832	Calvin Britian	Set Post	CP Pole	N 35°E	50.70'	24" Maple	S 40°E	65.05'	24" Maple	S 85°W	29.00'	3" Beech N 5°W 5'	Guy Pole	S 30°W	49.95'	18" Beech S 16° 8'	St Sign	W 20.29'	24" Beech	NNW 76.58'	Guy Pole	SW 46.63'	CIM	Power Pole	NE 50.68'	36" Maple	NW 63.90'	30" Maple	W 29.14'	Power Pole	SW 47.28'

B. Description of corner evidence found and/or method applied in restoring or reestablishing corner:

F-11
Found C.I.M. and is accepted as a careful and faithful perpetuation of the position of the original corner.

CP Pole	N 35°E	50.70'	St. Sign	W	20.29'	Power Pole	NE	50.68'
24" Maple	S 85°W	29.00'	24" Beech	NNW	76.58'	30" Maple	W	29.14'
Guy pole	S 30°W	46.95'	Guy Pole	SW	46.63'	Power Pole	SW	47.28'

P.A. 345 OTTAWA COUNTY
PEER APPROVED 10/23/95


Steven D. Lamphen
S.D.L.

C. Description of monument for corner and accessories established to perpetuate locating the position of the corner:

F-11

C.I.M. Az = MI State Plane Grid Direction

Centerline asphalt pavement	90°	3.5'
Remon Tag S. Side 12" Oak	299°12'	47.58'
Remon Tag E. Side TW 12" Cherry	200°30'	56.49'
Remon Tag NE Side 30" Maple	150°37'	81.94'
Remon Tag E. Side Power Pole	30°43'	50.77'
Tag #2442 S. side 30" Maple	261°28'	29.38'

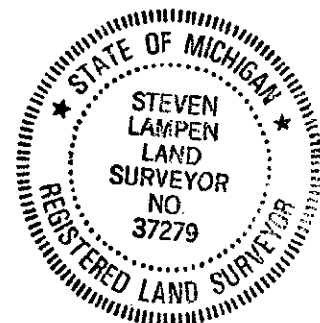

Signed by Steven Lamphen Date October 23, 1995

Surveyor's Michigan License No. 37279