

**OTTAWA COUNTY REMONUMENTATION
LAND CORNER RECORDATION CERTIFICATE**

Filing Requirement of Act 74, Mich. P.A. 1970

RECORDED

96 DEC 18 PM 4: 54

For corners in

Ottawa <small>(County)</small>	Located In:	Corner Code #
1. Public Land Survey	T 6N R 16W	G-1
	T _____ R _____	NW corner
	T _____ R _____	Section 3
	T _____ R _____	Port
2. Property Controlling in Section	S _____ T _____ R _____	Sheldon Twp.
	S _____ T _____ R _____	
3. Miscellaneous Property in Sec.	S _____ T _____ R _____	
	S _____ T _____ R _____	

Register of Deeds
**REGISTER OF DEEDS
OTTAWA COUNTY, MI**

Register of Deeds Stamp & File Number

4. Lot No. _____ / Recorded Plat _____
5. Private Claims _____

I, Steven Lampen, in a field survey on December 6 19 96, do hereby certify that under requirements of P.A. 74, Michigan P.A. of 1970, the corner points mentioned in lines 1 and 2 above were in conformance with regulations and rules therefore as required in the current manual of survey instructions of the United States Department of the Interior, Bureau of Land Management or by a decree of a Court of Law and/or that the corner points mentioned in lines 3, 4 and 5 above were in conformance with the rules of the Michigan Board of Land Surveyors or by a Decree of a Court of Law; established, re-established, monumented, re-monumented, recovered, found as expressed below:

NOTE: Not more than 4 corners, all in the same town and range, may be recorded on this certificate.

A. Description of original monument and accessories and/or subsequent restoration:

<p>G-1 GLO-Britain 1832 North boundary 1.00 West of post Pine 4S 25W 6 do 12S 55E 27</p> <p>LCRC L6 P67-1990 Reset cast iron monument East 66.06 to Grand haven Twp cor NW 48.66 to nail south side triple 20" wild cherry SW 107.57 to NE cor blk foundation SE 83.18 to nail E side twin 8" wild cherry</p>	<p>LCRC L1 P679-1972 Set cast iron monument Triple Cherry NW 48.70 G.H. cor E 66.00 12" Pine SW 65.55 Twin birch S 29.57</p>	<p>LCRC L5 P288-1988 Cast iron monument NE cor hse fdn SW 107.56 Tri Cherry NW 48.70 TW Birch S 29.57 Grand Haven cor E 66.06 12" Pine SW 65.55</p>
---	--	---

B. Description of corner evidence found and/or method applied in restoring or reestablishing corner:


<p>G-1 Found cast iron monument Triple cherry NW 48.70 12" Pine SW 65.55 Twin birch S 29.57 East 66.06 to Grand Haven Twp. cor</p>	<p>SW 107.57 to NE cor block foundation SE 83.18 to nail W side 14" pine NE 129.98 to nail E side twin 8" wild cherry</p>
--	---

Established corner at intersection of West line of Section 3 with the South line of Section 33, T7N, R16W and accepted it as a careful and faithful perpetuation of the position of the original corner.

PA. 345 OTTAWA COUNTY
PEER APPROVED 12-9-96

C. Description of monument for corner and accessories established to perpetuate locating the position of the corner:

<p>G-1 Established corner at the intersection of the West line of Section 3 with the South line of Section 33, T7N, R16W. Az.=Michigan State Plane Grid Direction. Found cast iron monument G-13, T7N, R16W=CIM in mon box Centerline E & W asphalt road pavement Centerline gravel road to south Remon tag NE side TW 12" maple NW corner house foundation Remon tag North side power pole Remon tag South side 12" Pine</p>	<p>359°00' 0.16' 90°49' 66.08' 0° 0' 90°49' 49' 306°28' 54.52' 254°23' 134.44' 71°59' 106.91' 123°22' 83.60'</p>
---	--

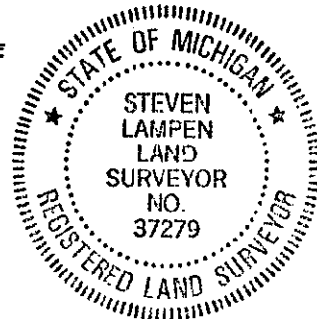

Signed by Steven Lampen Date DECEMBER 13, 1996
Surveyor's Michigan License No. 37279