

**SURVEY &  
REMONUMENTATION**

APR 05 1996

**OTTAWA COUNTY REMONUMENTATION  
LAND CORNER RECORDATION CERTIFICATE  
Filing Requirement of Act 74, Mich. P.A. 1970**

**COMMISSION**

For corners in  
Ottawa \_\_\_\_\_  
(County)

Located In:

Corner Code #

- |                                    |         |         |                    |
|------------------------------------|---------|---------|--------------------|
| 1. Public Land Survey              | T6N     | R16W    | G-2                |
|                                    | T _____ | R _____ | E 1/4 cor. Sec.    |
|                                    | T _____ | R _____ | 4, Port _____      |
|                                    | T _____ | R _____ | Sheldon Twp. _____ |
| 2. Property Controlling in Section | S _____ | T _____ | R _____            |
|                                    | S _____ | T _____ | R _____            |
| 3. Miscellaneous Property in Sec.  | S _____ | T _____ | R _____            |
|                                    | S _____ | T _____ | R _____            |

**RECORDED**

95 NOV 15 PM 2:14

*Elysha Ballman*  
REGISTER OF DEEDS  
OTTAWA COUNTY, MI

Register of Deeds Stamp & File Number

4. Lot No. \_\_\_\_\_, Recorded Plat \_\_\_\_\_  
5. Private Claims \_\_\_\_\_

I, Steven Lampen \_\_\_\_\_, in a field survey on October 12, 1995, do hereby certify that under requirements of P.A. 74, Michigan P.A. of 1970, the corner points mentioned in lines 1 and 2 above were in conformance with regulations and rules therefore as required in the current manual of survey instructions of the United States Department of the Interior, Bureau of Land Management or by a decree of a Court of Law and/or that the corner points mentioned in lines 3, 4 and 5 above were in conformance with the rules of the Michigan Board of Land Surveyors or by a Decree of a Court of Law; established, re-established, monumented, re-monumented, recovered, found as expressed below:

	A	B	C	D	E	F	G	H	I	J	K	L	M
1													
2	6	5	4	3	2								
3													
4	7	8	9	10	11	12							
5													
6	18	17	16	15	14	13							
7													
8	19	20	21	22	23	24							
9													
10	30	29	28	27	26	25							
11													
12	31	32	33	34	35	36							
13													

**NOTE: Not more than 4 corners, all in the same town and range, may be recorded on this certificate.**

**A. Description of original monument and accessories and/or subsequent restoration:**

- |   |  |  |
|---|--|--|
| <b>G-2</b>  | <b>L1 P679</b>   | <b>L5 P289</b>   |
| GLO<br>May 1832<br>Calvin Britain<br>Set Post<br>20" Hemlock N55°W 20'<br>18" Hemlock N60°E 14' | Found 1" Iron, raised with "T"<br>Iron (in Mon. Box)<br>8" Cherry N 42.79'<br>12" Pine ENE 90.12'<br>Triple Cherry SE 67.57' | "T" Iron in Mon Box<br>8" Cherry N 42.80'<br>12" Pine ENE 90.10'<br>Tri Cherry SE 67.60'<br>Iron S 33.00'<br>10" Pine NW 91.82'<br>8" Pine SW 72.39'<br>6" Cherry SSW 50.33'<br>10" Pine SW 46.73' |

**B. Description of corner evidence found and/or method applied in restoring or reestablishing corner:**


- G-2**  
Found C.I.M. in Mon Box and is accepted as a careful and faithful perpetuation of the position of the original corner.
- |                            |                      |
|----------------------------|----------------------|
| 8" Cherry N 42.79'         | 8" Cherry N 42.80'   |
| 12" Pine ENE 90.12'        | 12" Pine ENE 90.10'  |
| Found 1" Iron, raised with | 10" Pine NW 91.82'   |
| "T" Iron (in mon. box)     | 8" Pine SW 72.39'    |
|                            | 6" Cherry SSW 50.33' |
|                            | 10" Pine SW 46.73'   |

PA. 345 OTTAWA COUNTY  
PEER APPROVED 10/23/95

*Robert P. McDowell*  
YDN

**C. Description of monument for corner and accessories established to perpetuate locating the position of the corner:**

- G-2**
- |                                |                                    |
|--------------------------------|------------------------------------|
| C.I.M. in Mon Box              | Az = MI State Plane Grid Direction |
| Remon Tag E. side TW 6" Cherry | 184° 44' 50.18'                    |
| Remon Tag N side 8" Pine       | 123° 14' 57.14'                    |
| Remon Tag S side 16" Pine      | 71° 58' 91.17'                     |
| Remon Tag W side 8" Cherry     | 348° 51' 43.12'                    |
| Remon Tag S side 8" Pine       | 294° 20' 91.86'                    |

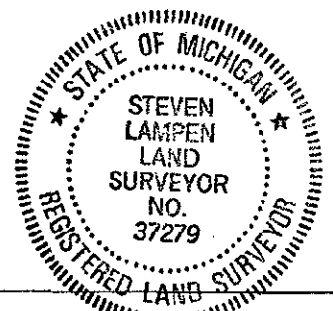

Signed by Steven Lampen

Date October 23, 1995

Surveyor's Michigan License No. 37279

FORM APPROVED BY MICHIGAN STATE BOARD OF LAND SURVEYORS, JAN. 28, 1971  
REVISED MAY 14, 1976  
REVISED JAN., 1983  
ADAPTED FOR WORD PROCESSING MARCH, 1983