

SURVEY & REMONUMENTATION

APR 05 1996

COMMISSION

OTTAWA COUNTY REMONUMENTATION LAND CORNER RECORDATION CERTIFICATE

Filing Requirement of Act 74, Mich. P.A. 1970

For corners in Ottawa _____ Located In: _____ Corner Code # _____
 (County)

1. Public Land Survey T6N R16W G-3
 T _____ R _____ SW 1/4 cor. Sec.
 T _____ R _____ 3, Port
 T _____ R _____ Sheldon Twp.

2. Property Controlling S _____ T _____ R _____
 in Section S _____ T _____ R _____

3. Miscellaneous S _____ T _____ R _____
 Property in Sec. S _____ T _____ R _____

4. Lot No. _____, Recorded Plat _____

5. Private Claims _____

RECORDED
 95 NOV 15 PM 2:14
Dorothy K. Redmond
 REGISTER OF DEEDS
 OTTAWA COUNTY, MI
Register of Deeds Stamp & File Number

I, Steven Lampen _____, in a field survey on October 12 1995, do hereby certify that under requirements of P.A. 74, Michigan P.A. of 1970, the corner points mentioned in lines 1 and 2 above were in conformance with regulations and rules therefore as required in the current manual of survey instructions of the United States Department of the Interior, Bureau of Land Management or by a decree of a Court of Law and/or that the corner points mentioned in lines 3, 4 and 5 above were in conformance with the rules of the Michigan Board of Land Surveyors or by a Decree of a Court of Law; established, re-established, monumented, re-monumented, recovered, found as expressed below:

1	A	B	C	D	E	F	G	H	I	J	K	L	M
2	6	5	4	3	2	1							
3													
4	7	8	9	10	11	12							
5													
6	18	17	16	15	14	13							
7													
8	19	20	21	22	23	24							
9													
10	30	29	28	27	26	25							
11													
12	31	32	33	34	35	36							
13													

NOTE: Not more than 4 corners, all in the same town and range, may be recorded on this certificate.

A. Description of original monument and accessories and/or subsequent restoration:
G-3

GLO May 1832 Surveyor - Calvin Britain Set corner 12' Beech N 15° E 23' 7" Beech N 19° W 23'	LCRC L 2-P 165 Found 1 1/4" pipe 24" Twin Oak 20" Beech 14' Triple Oak	SE 19.90' S 55.35' NW 5.37'	LCRC L 5-P 287 1 1/4" pipe 24" Twin Oak 20" Beech 14" Triple Oak 10" Oak	SE 19.90' S 55.35' NW 5.37' N 17.25'
---	--	-----------------------------------	---	---

B. Description of corner evidence found and/or method applied in restoring or reestablishing corner:
G-3
 Found iron pipe and is accepted as a careful and faithful perpetuation of the position of the original corner.


24" Twin Oak SE 19.90'	24" twin Oak SE 19.90'
20" Beech S 55.35'	20" Beech S 55.35'
14" Triple Oak NW 5.37'	14" triple Oak NW 5.37'
	10" Oak N 17.25'

PA. 345 OTTAWA COUNTY
 PEER APPROVED 10/23/95

Robert P. Redmond
 RDR

C. Description of monument for corner and accessories established to perpetuate locating the position of the corner:
G-3
 Set remon. AZ = Compass

Remon. tag S side 12" triple Oak	305° 5.47'
Remon. tag W side 16" Oak	3° 17.27'
Remon. tag SW side 18" twin Oak	122° 21.38'
Remon. tag E side 8" Beech	178° 35.92'

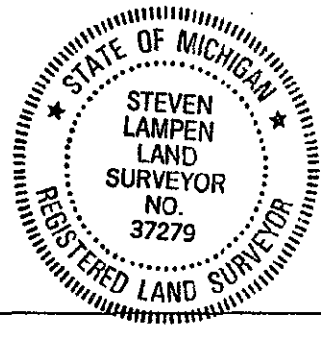

Signed by Steven Lampen Date October 23, 1995

Surveyor's Michigan License No. 37279

FORM APPROVED BY MICHIGAN STATE BOARD OF LAND SURVEYORS, JAN. 28, 1971
 REVISED MAY 14, 1971
 REVISED JAN., 1988
 ADAPTED FOR WORD PROCESSING MARCH, 1989