

**SURVEY &  
REMONUMENTATION**

APR 05 1996

**OTTAWA COUNTY REMONUMENTATION  
LAND CORNER RECORDATION CERTIFICATE**  
Filing Requirement of Act 74, Mich. P.A. 1970

For corners of **COMMISSION**  
Ottawa  
(County)

Located In:

Corner Code #

- |                         |     |      |                    |
|-------------------------|-----|------|--------------------|
| 1. Public Land Survey   | T6N | R16W | G-5                |
|                         | T   | R    | (NW cor. Sec. 15,  |
|                         | T   | R    | Port Sheldon Twp.) |
|                         | T   | R    |                    |
| 2. Property Controlling | S   | T    | R                  |
| in Section              | S   | T    | R                  |
| 3. Miscellaneous        | S   | T    | R                  |
| Property in Sec.        | S   | T    | R                  |

RECORDED

95 NOV 15 PM 2:07

*Dorothy Redman*  
REGISTER OF DEEDS  
OTTAWA COUNTY, MI

Register of Deeds Stamp & File Number

4. Lot No. \_\_\_\_\_, Recorded Plat \_\_\_\_\_  
5. Private Claims \_\_\_\_\_

1	A	B	C	D	E	F	G	H	I	J	K	L	M
2	6	5	4	3	2	1							
3													
4	7	8	9	10	11	12							
5													
6	18	17	16	15	14	13							
7													
8	19	20	21	22	23	24							
9													
10	30	29	28	27	26	25							
11													
12	31	32	33	34	35	36							
13													

I, Steven Lampen, in a field survey on October 23 1995, do hereby certify that under requirements of P.A. 74, Michigan P.A. of 1970, the corner points mentioned in lines 1 and 2 above were in conformance with regulations and rules therefore as required in the current manual of survey instructions of the United States Department of the Interior, Bureau of Land Management or by a decree of a Court of Law and/or that the corner points mentioned in lines 3, 4 and 5 above were in conformance with the rules of the Michigan Board of Land Surveyors or by a Decree of a Court of Law; established, re-established, monumented, re-monumented, recovered, found as expressed below:

**NOTE: Not more than 4 corners, all in the same town and range, may be recorded on this certificate.**

A. Description of original monument and accessories and/or subsequent restoration:

**G-5**  
GLO Survey Notes  
1832, Surveyor - Samuel Marrs  
Set post  
12" Hemlock S 30° E 20 links  
4" Beech N 65° W 16 links  
LCRC L 2-P 741 1974  
NW corner 15, Found 3/4" Shaft  
S 61° E 71.71', Power pole, spike & tag  
S 50° W 48.85', Anchor pole, P.K. & tag  
N 22° E 81.6', fence corner (SE cor. of enclosure)

B. Description of corner evidence found and/or method applied in restoring or reestablishing corner:


**G-5**  
Found frost pin and is accepted as a careful and faithful perpetuation of the position of the original corner.  
Fence corner (SE corner of enclosure) N 22° E 81.6'

P.A. 345 OTTAWA COUNTY  
PEER APPROVED 10/23/95

*Madog D. Redwood*  
YDM

C. Description of monument for corner and accessories established to perpetuate locating the position of the corner:

**G-5**  
Set Ottawa County Remon. iron & cap  
Centerline SE fence corner post  
Centerline top hydrant  
NE corner metal building  
centerline top hydrant  
NE corner J.H. Campbell Unit No. 3,  
building metal siding  
AZ = MI State plane grid direction  
19° 24' 81.01'  
311° 57' 70.75'  
323° 58' 95.39'  
179° 12' 134.27'  
189° 10' 319.62'

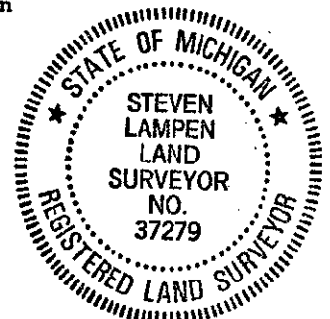

Signed by Steven Lampen

Date October 23, 1995

Surveyor's Michigan License No. 37279