

SURVEY & REMONUMENTATION

APR 24 1995

**OTTAWA COUNTY REMONUMENTATION
LAND CORNER RECORDATION CERTIFICATE
Filing Requirement of Act 74, Mich. P.A. 1970**

RECORDED

94 DEC 14 AM 10:02

Richard Robinson
REGISTER OF DEEDS
OTTAWA COUNTY, MI

For corners in **COMMISSION**

Ottawa (County) Located In: Corner Code #

1. Public Land Survey T 6N R 16W G-7 NW Cor
 T _____ R _____ Sec 22
 T _____ R _____ Port Sheldon Twp.
 T _____ R _____


2. Property Controlling S _____ T _____ R _____
 in Section S _____ T _____ R _____

3. Miscellaneous S _____ T _____ R _____
 Property in Sec. S _____ T _____ R _____

4. Lot No. _____, Recorded Plat _____

5. Private Claims _____

Register of Deeds Stamp & File Number

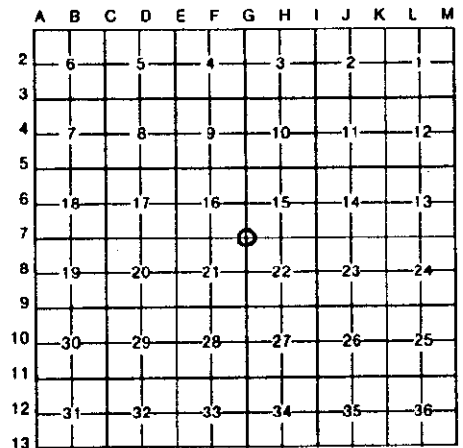

I, John P. Clapp, in a field survey on December 3, 19 94, do hereby certify that under requirements of P.A. 74, Michigan P.A. of 1970, the corner points mentioned in lines 1 and 2 above were in conformance with regulations and rules therefore as required in the current manual of survey instructions of the United States Department of the Interior, Bureau of Land Management or by a decree of a Court of Law and/or that the corner points mentioned in lines 3, 4 and 5 above were in conformance with the rules of the Michigan Board of Land Surveyors or by a Decree of a Court of Law; established, re-established, monumented, re-monumented, recovered, found as expressed below:

NOTE: Not more than 4 corners, all in the same town and range, may be recorded on this certificate.

A. Description of original monument and accessories and/or subsequent restoration:

G-7 Govt Land Office Survey Notes 1832-Surveyor, Calvin Britain Set 1/2 mile post in brook 6" Maple S16°E 50 links 10" Red Oak N1°W 30 links See reverse side for additional recordings (Liber 4, Pg. 31)	G-7 Recorded in Liber 2, Page 693, Oct. 22, 1974 Fd Iron Pipe SE Cor Bldg N3°W 89.47' T. Pole N60°E 22.10' T. Pole S64°E 59.33' St Sign N76°E 85.54' St Lt. Pole S. 94.23'	G-7 Recorded in Liber 2 Page 741, Feb 13, 1975 Fd 3" Pipe T. Pole N57°E 22.20' 12" Pine S60°W 2.49' 10" Pine N13°E 8.27' Edge bl. top nw 16'
--	---	--

B. Description of corner evidence found and/or method applied in restoring or reestablishing corner:

Richard P. Nedwell P.A. 345 OTTAWA COUNTY
PEER APPROVED 12/12/94

G-7

Found cast iron monument and accepted it as a careful and faithful perpetuation of the position of the original corner

Found Nail in NW Side 12" Pine	AZ 230°	247'
Found Nail & Tag in NW Side 12" Pine	AZ 230°	2.41'
Found P.K. Nail & Tag in E Side 12" Pine	AZ. 10°	8.28'
Most Easterly SE Corner of Brick Building	AZ. 297°	157.23'


C. Description of monument for corner and accessories established to perpetuate locating the position of the corner:

G-7

Found Cast Iron Monument

O.C Remon Tag & Nail in SE Side 12" Pine	AZ. 230°	2.37"
O.C. Remon Tag & Nail in N Side 12" Pine	AZ. 265°	19.61'
O.C. Remon Tag & Nail in E Side Power Pole	AZ. 171°	46.32'
O.C. Remon Tag & Nail in W Side 12" Pine	AZ. 10°	8.33'

Signed by John P. Clapp *John P. Clapp* Date Dec. 6, 1994
 Surveyor's Michigan License No. 14091

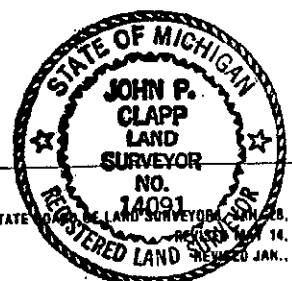

FORM APPROVED BY MICHIGAN STATE BOARD OF LAND SURVEYORS, JAN. 28, 1971
 REVISED MAY 14, 1975
 REVISED JAN., 1983

G-7

Recorded in Liber 4,
Page 31, Jan. 30, 1980

Found 3" iron pipe with 1 1/2" iron pipe below it,
Set Cast Iron Monument

Telephone Pole	NE	22.31'
12" Pine	SW	2.31'
Sign Base	SW	93.48'
10" Pine	NNE	8.20'

1980
JAN 30
CORNER
N 1/2
117