

**SURVEY &
REMONUMENTATION**

APR 05 1996

**OTTAWA COUNTY REMONUMENTATION
LAND CORNER RECORDATION CERTIFICATE**

COMMISSION Filing Requirement of Act 74, Mich. P.A. 1970

For corners in
Ottawa _____ Located In: _____ Corner Code # _____
(County)

1. Public Land Survey T6N R16W G-8
T _____ R _____ E 1/4 cor. Sec.
T _____ R _____ 21, Port
T _____ R _____ Sheldon Twp.

2. Property Controlling S _____ T _____ R _____
in Section S _____ T _____ R _____

3. Miscellaneous S _____ T _____ R _____
Property in Sec. S _____ T _____ R _____

RECORDED

95 NOV 15 PM 2:06

Dorothy Callman
REGISTER OF DEEDS
OTTAWA COUNTY, MI

Register of Deeds Stamp & File Number

4. Lot No. _____, Recorded Plat _____
5. Private Claims _____

I, Steven Lampen _____, in a field survey on October 12, 1995, do hereby certify that under requirements of P.A. 74, Michigan P.A. of 1970, the corner points mentioned in lines 1 and 2 above were in conformance with regulations and rules therefore as required in the current manual of survey instructions of the United States Department of the Interior, Bureau of Land Management or by a decree of a Court of Law and/or that the corner points mentioned in lines 3, 4 and 5 above were in conformance with the rules of the Michigan Board of Land Surveyors or by a Decree of a Court of Law; established, re-established, monumented, re-monumented, recovered, found as expressed below:

NOTE: Not more than 4 corners, all in the same town and range, may be recorded on this certificate.

A. Description of original monument and accessories and/or subsequent restoration:

G-8		LCRC L 1-P 317		LCRC L 2-P 517	
GLO	May 1832	Nail in side 12" W. Cherry	SW 25.35'	Found well point	
Surveyor - Calvin Britain	Set post	Nail in side 6" Cherry	SE 30.91'	18" Oak	NE 35.19'
6" Maple S 16° E 50'	10" Red Oak N 01° W 30'	Nail in side 20" Oak	NNE 36.67'	NW corner headwall	NE 18.70'
		Nail in side 24" Oak	NW 40.49'	Concrete monument	N 233.00'
		NE corner of NW wingwall of bridge ENE 19.48'		20" Oak	NW 39.65'
				24" Oak	SW 51.85'

Continued on reverse side

B. Description of corner evidence found and/or method applied in restoring or reestablishing corner:

G-8
Found CIM in monument box and is accepted as a careful and faithful perpetuation of the position of the original corner.

Nail in side 20" Oak NNE 36.67'	18" Oak	NE 35.19'
Nail in side 24" Oak NW 40.49'	Concrete monument	N 233.00'
	20" Oak	NW 39.65'


Continued on reverse side

P.A. 345 OTTAWA COUNTY
PEER APPROVED 10/23/95

Steven Lampen
Madison P. Newswell

C. Description of monument for corner and accessories established to perpetuate locating the position of the corner:

G-8	AZ = MI State plane grid direction	
CIM in monument box	24° 04'	36.64'
Remon. tag in E side 30" Oak	125° 34'	175.36'
NE Corner garage, brick	320° 47'	40.06'
Remon. tag in SW side 30" Oak	180°	0.5'
Centerline asphalt pavement	242° 45'	112.89'
Remon. tag in SE Side 12" Oak		

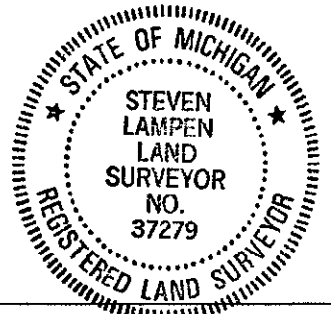

Signed by Steven Lampen

Date October 23, 1995

Surveyor's Michigan License No. 37279

FORM APPROVED BY MICHIGAN STATE BOARD OF LAND SURVEYORS, JAN. 28, 1971
REVISED MAY 14, 1976
REVISED JAN., 1983
ADAPTED FOR WORD PROCESSING MARCH, 1983

A.

LCRC L 4-P 31

Set cast iron monument inscribed "Section Corner"

New ties taken:

Set T. nail in side 27" Red Oak	NE 36.38'
Set T. nail in side 26" Red Oak	NW 40.11'
Set T. nail in side 11" Black Cherry	SE 31.33'
Centerline creek and culvert	E 30' ±
centerline existing road	S 4' ±

B.

Set T. nail in side 27" Red Oak	NE 36.38'
Set T. nail in side 26" Red Oak	NW 40.11'
centerline creek and culvert	E 30' ±

\$ 11.00 CORNER