

SURVEY & REMONUMENTATION

APR 24 1995

COMMISSION

**OTTAWA COUNTY REMONUMENTATION
LAND CORNER RECORDATION CERTIFICATE
Filing Requirement of Act 74, Mich. P.A. 1970**

RECORDED

94 DEC 14 AM 9:43

Robert L. Anderson
REGISTER OF DEEDS
OTTAWA COUNTY, MI


For corners in

<u>Ottawa</u> <small>(County)</small>	Located In:	Corner Code #:
1. Public Land Survey	T <u>6N</u> R <u>16W</u>	<u>G-11 NW Cor.</u>
	T _____ R _____	<u>Sec 34</u>
	T _____ R _____	<u>Port Sheldon Twp.</u>
	T _____ R _____	_____
2. Property Controlling in Section	S _____ T _____ R _____	_____
	S _____ T _____ R _____	_____
3. Miscellaneous Property in Sec.	S _____ T _____ R _____	_____
	S _____ T _____ R _____	_____

Register of Deeds Stamp & File Number

4. Lot No. _____, Recorded Plat _____
5. Private Claims _____

I, David R. Greer, in a field survey on December 12, 19 94, do hereby certify that under requirements of P.A. 74, Michigan P.A. of 1970, the corner points mentioned in lines 1 and 2 above were in conformance with regulations and rules therefore as required in the current manual of survey instructions of the United States Department of the Interior, Bureau of Land Management or by a decree of a Court of Law and/or that the corner points mentioned in lines 3, 4 and 5 above were in conformance with the rules of the Michigan Board of Land Surveyors or by a Decree of a Court of Law; established, re-established, monumented, re-monumented, recovered, found as expressed below:

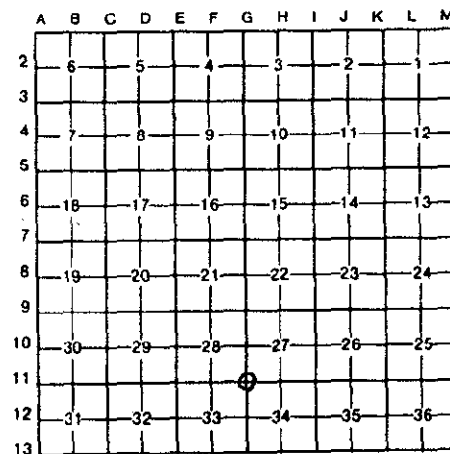

NOTE: Not more than 4 corners, all in the same town and range, may be recorded on this certificate.

A. Description of original monument and accessories and/or subsequent restoration:

G-11 Govt Land Office Survey Notes 1832-Surveyor, Calvin Britain Set corner 18" Beech N43°E 6 links 3" Beech N40°W 13 links	G-11 Recorded in Liber 1, Page 155, Nov. 4, 1971 Fd 2" Iron Pipe 8" Oak SE 48.55' 8" Tri Cherry N 56.50' 12" Twin Oak N80°W 85.06' Power Pole S80°E 122.74'	G-11 Recorded in Liber 2 Page 507, Apr 5, 1974 Fd 2" Iron Pipe, Set C.I.M. Power Pole S80°E 122.72' 12" B. Oak S30°E 48.43' 12" Tw Cherry N 56.51' 8" Tri. Cherry N40°E 40.97'
---	---	--

B. Description of corner evidence found and/or method applied in restoring or reestablishing corner:


Robert P. Redwood

P.A. 345 OTTAWA COUNTY
PEER APPROVED 12/12/94

G-11
Found cast iron monument in monument box and accepted it as a careful and faithful perpetuation of the position of the original corner
Power Pole S80°E 122.72'
12" Black Oak S30°E 48.43'

C. Description of monument for corner and accessories established to perpetuate locating the position of the corner:

G-11
Found Cast Iron Monument in Monument Box
O.C. Remon Tag & Nail in SSW Side 24" Oak AZ. 292° 106.76'
O.C. Remon Tag & Nail in SE Side 18" Tri. Oak AZ. 49° 45.10'
O.C. Remon Tag & Nail in N Side Power Pole AZ. 107° 123.43'
O.C. Remon Tag & Nail in SW Side 22" Oak AZ. 144° 48.68'

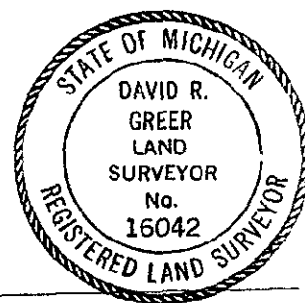

Signed by David R. Greer *David R. Greer* Date Dec. 12, 1994

Surveyor's Michigan License No. 16042

FORM APPROVED BY MICHIGAN STATE BOARD OF LAND SURVEYORS, JAN. 28, 1971
REVISED MAY 14, 1975
REVISED JAN., 1983