

**Ottawa County Remonumentation  
LAND CORNER RECORDATION CERTIFICATE**  
Filing Requirement of Act 74, Mich. P.A. 1970

**RECORDED**

96 DEC 18 PM 4: 57

*Richard Callman*  
REGISTER OF DEEDS  
OTTAWA COUNTY, MI

For corners in		Located In:	Corner Code #
<u>Ottawa</u>			
(County)			
1. Public Land Survey	T 6N R 16W		H-1
	T R		Port Sheldon
	T R		Twp.
	T R		NORTH 1/4 CORNER
2. Property Controlling	S T R		SECTION 3
in Section	S T R		
3. Miscellaneous	S T R		
Property in Sec.	S T R		

Register of Deeds Stamp & File Number

4. Lot No. \_\_\_\_\_, Recorded Plat \_\_\_\_\_  
5. Private Claims \_\_\_\_\_

I, Steven Lampen, in a field survey on Nov. 7 1996, do hereby certify that under requirements of P.A. 74, Michigan P.A. of 1970, the corner points mentioned in lines 1 and 2 above were in conformance with regulations and rules therefore as required in the current manual of survey instructions of the United States Department of the Interior, Bureau of Land Management or by a decree of a Court of Law and/or that the corner points mentioned in lines 3, 4 and 5 above were in conformance with the rules of the Michigan Board of Land Surveyors or by a Decree of a Court of Law; established, re-established, monumented, re-monumented, recovered, found as expressed below:

1	A	B	C	D	E	F	G	H	I	J	K	L	M
2		6	5	4	3	2	1						
3													
4		7	8	9	10	11	12						
5													
6		18	17	16	15	14	13						
7													
8		19	20	21	22	23	24						
9													
10		30	29	28	27	26	25						
11													
12		31	32	33	34	35	36						
13													

**NOTE: Not more than 4 corners, all in the same town and range, may be recorded on this certificate.**

**A. Description of original monument and accessories and/or subsequent restoration:**

H-1	LCRC	LCRC
GLO-corner not set by GLO	L1 P679 - 1972	L5 P288 - 1983 cast iron monument
	Set cast iron monument	NE cor hse fndn SE 150.42
	Mid-way and on line	NW cor conc wingwall SSE 115.66
	Quad cherry N 36.88	10" pine NE 48.95
	10" cherry SW 24.09	10" pine SW 47.56
	6" pine SE 42.60	iron E 46.10
	30" oak ENE 118.78	
LCRC		
L6 P67 - reset cast iron monument		
East 46.07 to Grand Haven Twp cor (H-13)		
N 37.03 to nail W side 14" wild cherry		
NE 49.15 to nail SE side 12" pine		
SSE 31.23 to nail E side fence post		

**B. Description of corner evidence found and/or method applied in restoring or reestablishing corner:**

H-1

Found cast iron monument in monument box	
Quad cherry	N 36.88
30" oak	ENE 118.78
NE cor hse fndn	SE 150.42
NW cor conc wingwall	SSE 115.66
10" pine	NE 48.95
iron	E 46.10
N 37.03 to nail W side 14" wild cherry	
NE 49.15 to nail SE side 12" pine	
SSE 31.23 to nail E side fence post	

**PA. 345 OTTAWA COUNTY**  
**PEER APPROVED 12-9-96**

*S. D. N.*


This corner not monumented by original GLO survey. This monument is accepted as the best available evidence of the position of the corner.

Established corner at the intersection of the N & S 1/4 line of Section 3 with the South line of Section 34, T7N, R16W

**C. Description of monument for corner and accessories established to perpetuate locating the position of the corner:**

H-1

Established corner at the intersection of the N & S 1/4 line of Section 3 with the South line of Section 34, T7N, R16W. Az. = Michigan State Place Grid Direction.	
Centerline east and west asphalt road pavement	N 0
Cast iron monument in monument box	178°47' 0.07
H-13 T7N, R16W = Cast iron monument in mon box	90°57' 46.11
Mid-point G-1 and I-1	270°57' 0.04
NE corner attached garage fndn	138°13' 150.48
NW corner concrete wingwall	166°55' 115.74
Remon tag W side 6" oak	183°15' 30.77
Remon tag SW side twin 10" cherry	306°42' 63.46
Remon tag S side 30" oak	78°27' 120.35

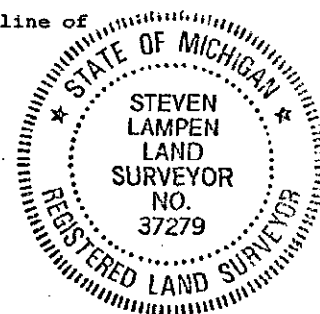

Signed by Steven Lampen Date November 11, 1996

Surveyor's Michigan License No. 37279

FORM APPROVED BY MICHIGAN STATE BOARD OF LAND SURVEYORS, JAN. 28, 1971  
REVISED MAY 14, 1976  
REVISED JAN., 1983  
ADAPTED FOR WORD PROCESSING MARCH, 1993

