

SURVEY & REMONUMENTATION

OCT 24 1994

COMMISSION

**OTTAWA COUNTY REMONUMENTATION
LAND CORNER RECORDATION CERTIFICATE
Filing Requirement of Act 74, Mich. P.A. 1970**

RECORDED

94 OCT -7 PM 12:32

Elizabeth Redman
REGISTER OF DEEDS
OTTAWA COUNTY, MI

For corners in

<u>Ottawa</u> (County)	Located In:	Corner Code #/
1. Public Land Survey	T <u>6N</u> R <u>16W</u>	<u>H-13 (S 1/4 Cor. Sec. 34)</u>
	T _____ R _____	<u>Port Sheldon Twp.</u>
	T _____ R _____	_____
	T _____ R _____	_____
2. Property Controlling in Section	S _____ T _____ R _____	_____
	S _____ T _____ R _____	_____
3. Miscellaneous Property in Sec.	S _____ T _____ R _____	_____
	S _____ T _____ R _____	_____
4. Lot No. _____, Recorded Plat _____		
5. Private Claims _____		

Register of Deeds Stamp & File Number

I, Gerald T. Ford, in a field survey on April 1, 19 94, do hereby certify that under requirements of P.A. 74, Michigan P.A. of 1970, the corner points mentioned in lines 1 and 2 above were in conformance with regulations and rules therefore as required in the current manual of survey instructions of the United States Department of the Interior, Bureau of Land Management or by a decree of a Court of Law and/or that the corner points mentioned in lines 3, 4 and 5 above were in conformance with the rules of the Michigan Board of Land Surveyors or by a Decree of a Court of Law; established, re-established, monumented, re-monumented, recovered, found as expressed below:

A	B	C	D	E	F	G	H	I	J	K	L
2	6	5	4	3	2	1					
3											
4	7	8	9	10	11	12					
5											
6	18	17	16	15	14	13					
7											
8	19	20	21	22	23	24					
9											
10	30	29	28	27	26	25					
11											
12	31	32	33	34	35	36					
13											

NOTE: Not more than 4 corners, all in the same town and range, may be recorded on this certificate.

A. Description of original monument and accessories and/or subsequent restoration:


H-13 Government Land Office Survey Notes 1832 - Surveyor, Calum Britian Post 30" Hemlock N63°E 42 links 10" Beech N80°W 10 links	H-13 Recorded in Liber 5 Page 99 Dec. 20, 1983 Cast iron monument Park Twp. Corner W 50.48' 28" Maple SW 92.21' Twin 6" Cherry S 23.62' 12" Pine NW 88.64' Power Pole NE 53.57'
---	--

B. Description of corner evidence found and/or method applied in restoring or reestablishing corner:

H-13 Found cast iron monument in monument box and accepted it as a careful and faithful perpetuation of the position of the original corner Found Nail in NE face 12" Pine Found Nail in NW face 28" Maple Found Nail in N face Twin 6" Wild Cherry Found in Mon Box (H-1, T5N, R16W)	AZ 322°37' 88.58' AZ 240°57' 92.14' AZ 178°11' 23.63' AZ 270°12' 50.46'
--	--

C. Description of monument for corner and accessories established to perpetuate locating the position of the corner:

H-13 Cast Iron Monument in Monument Box AZ - Michigan State Grid Direction O.C. Remon tag & nail in N face P. Pole O.C. Remon tag & nail in W face P. Pole O.C. Remon tag & nail in NE face 10" Pine O.C. Remon tag & nail in N face 28" Maple O.C. CIM in Mon Box(H-1 T5N, R16W) CL Blacktop road	P.A. 345 OTTAWA COUNTY PEER APPROVED <i>6/29/94</i> <i>Jordan B. Melnychuk</i> AZ. 126°42' 36.92' AZ. 42°00' 53.72' AZ. 310°49' 83.47' AZ. 241°09' 91.66' AZ. 270°12' 50.46' North 3.7 ±
--	---

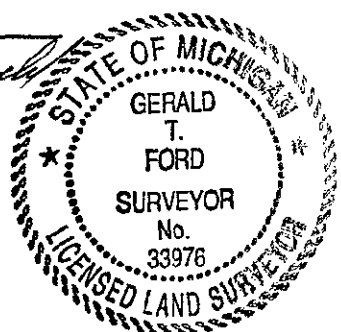

Signed by Gerald T. Ford Date July 13, 1994

Surveyor's Michigan License No. 33976