

**Ottawa County Remonumentation
LAND CORNER RECORDATION CERTIFICATE
Filing Requirement of Act 74, Mich. P.A. 1970**

RECORDED

96 DEC 18 PM 4:54

Polynomial Robinson
**REGISTER OF DEEDS
OTTAWA COUNTY, MI**

For corners in			
<u>Ottawa</u>	Located In:	Corner Code #	
(County)			
1. Public Land Survey	T <u>6N</u> R <u>16W</u>	<u>I-1</u>	
	T _____ R _____	<u>Port Sheldon</u>	
	T _____ R _____	<u>Twp.</u>	
	T _____ R _____	<u>NE CORNER</u>	
2. Property Controlling in Section	S _____ T _____ R _____	<u>SECTION 3</u>	
	S _____ T _____ R _____		
3. Miscellaneous Property in Sec.	S _____ T _____ R _____		
	S _____ T _____ R _____		
4. Lot No. _____, Recorded Plat _____			
5. Private Claims _____			

Register of Deeds Stamp & File Number

I, Steven Lampen, in a field survey on Nov. 7 1996, do hereby certify that under requirements of P.A. 74, Michigan P.A. of 1970, the corner points mentioned in lines 1 and 2 above were in conformance with regulations and rules therefore as required in the current manual of survey instructions of the United States Department of the Interior, Bureau of Land Management or by a decree of a Court of Law and/or that the corner points mentioned in lines 3, 4 and 5 above were in conformance with the rules of the Michigan Board of Land Surveyors or by a Decree of a Court of Law; established, re-established, monumented, re-monumented, recovered, found as expressed below:

NOTE: Not more than 4 corners, all in the same town and range, may be recorded on this certificate.

- A. Description of original monument and accessories and/or subsequent restoration:
- | | |
|--|-------------------------------------|
| I-1 | LCRC L1 P123 - 1971 |
| GLO-Britain 1832 | Found pipe; set cast iron monument. |
| North boundary 40 west of post. Set corner | 16" ash SE 37.03 |
| Hemlock 10 S49E 15 | 16" ash SE 30.01 |
| Hemlock 5 S32W 5 | 18" ash N 5°W 26.18 |
| | 12" ash N70°W 86.07 |
| | 16" oak S70°W 93.24 |
| LCRC L6 P68 - 1990 | |
| Reset cast iron monument | |
| East 26.44 to Grand Haven Twp. cor. (I-13) | |
| NE 100.80 to nail W side power pole | |
| NW 89.85 to nail E side 8" oak | |
| SW 88.02 to PK nail N side power pole | |
| SSW 84.83 to nail E side 12" pine | |

1	A	B	C	D	E	F	G	H	I	J	K	L	M
2	6	5	4	3	2	1							
3													
4	7	8	9	10	11	12							
5													
6	18	17	16	15	14	13							
7													
8	19	20	21	22	23	24							
9													
10	30	29	28	27	26	25							
11													
12	31	32	33	34	35	36							
13													

LCRC 15 P288
Cast iron monument
8" oak NW 89.85
28" oak WSW 93.95
P.P. NE 100.87
24" ash NNW 29.06
Cast iron monument E 26.40

- B. Description of corner evidence found and/or method applied in restoring or reestablishing corner:

I-1
Found cast iron monument in monument box

16" oak	S70°W	93.24
8" oak	NW	89.85
28" oak	WSW	93.95
P.P.	NE	100.87
24" ash	NNW	29.06
Cast iron monument	E	26.40
SSW 84.43 to nail E side 12" pine		

P.A. 345 OTTAWA COUNTY
PEER APPROVED 12-9-96


S. D. N.

Established corner at intersection of East line Section 3 with South line of Section 34, T7N, R16W and accepted it as a careful and faithful perpetuation of the position of the original corner.

- C. Description of monument for corner and accessories established to perpetuate locating the position of the corner:

I-1
Established corner at intersection of East line Section 3 with the South line of Section 34, T7N, R16W. Az.= Michigan State Plane Grid Direction.

Centerline east and west asphalt road pavement	N	0
Cast iron monument in monument box	178°50'	0.04
I-13 T7N R16W = cast iron monument in monument box	90°57'	26.46
Remon tag WNW side power pole	56°22'	101.43
Remon tag W side twin 20" ash	340°58'	28.96
Remon tag SW side 12" oak	286°19'	111.14
Remon tag N side 26" oak	257°23'	102.88
Remon tag W side 12" pine	206°48'	84.4

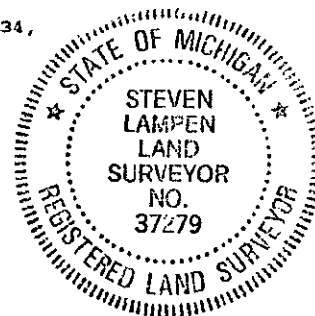

Signed by Steven Lampen Date November 11, 1996

Surveyor's Michigan License No. 37279

FORM APPROVED BY MICHIGAN STATE BOARD OF LAND SURVEYORS, JAN. 28, 1971
REVISED MAY 14, 1976
REVISED JAN., 1983
ADAPTED FOR WORD PROCESSING MARCH, 1983