

SURVEY & REMONUMENTATION

DEC 01 1993

OTTAWA COUNTY REMONUMENTATION LAND CORNER RECORDATION CERTIFICATE Filing Requirement of Act 74, Mich. P.A. 1970

RECORDED

93 NOV 11 AM 11:56


For corners in

Phyllis Williams
REGISTER OF DEEDS
OTTAWA COUNTY, MI

<u>Ottawa</u> (County)	Located In:	Corner Code #/
1. Public Land Survey	T <u>6N</u> R <u>16W</u>	<u>I-3 (NW Sec. 11)</u>
	T _____ R _____	<u>Port Sheldon Twp.</u>
	T _____ R _____	_____
	T _____ R _____	_____
2. Property Controlling in Section	S _____ T _____ R _____	_____
	S _____ T _____ R _____	_____
3. Miscellaneous Property in Sec.	S _____ T _____ R _____	_____
	S _____ T _____ R _____	_____
4. Lot No. _____, Recorded Plat _____		
5. Private Claims _____		

Register of Deeds Stamp & File Number

I, David R. Greer, in a field survey on September 15, 19 93, do hereby certify that under requirements of P.A. 74, Michigan P.A. of 1970, the corner points mentioned in lines 1 and 2 above were in conformance with regulations and rules therefore as required in the current manual of survey instructions of the United States Department of the Interior, Bureau of Land Management or by a decree of a Court of Law and/or that the corner points mentioned in lines 3, 4 and 5 above were in conformance with the rules of the Michigan Board of Land Surveyors or by a Decree of a Court of Law; established, re-established, monumented, re-monumented, recovered, found as expressed below:

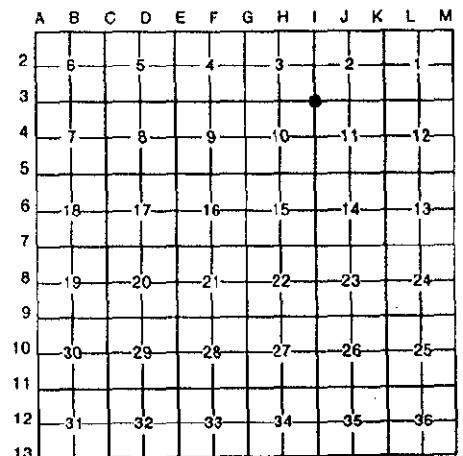

NOTE: Not more than 4 corners, all in the same town and range, may be recorded on this certificate.

A. Description of original monument and accessories and/or subsequent restoration:

Recorded in Liber 5 Page 287, March 18, 1938

I-3
Cast Iron Monument
50" Maple WNW 133.89'
CL Street Sign SE 29.41'
10" Pine SSE 61.95'

Recorded in Liber 1, Page 675, Oct. 13, 1972

I-3
Found Cast Iron Monument
50" Maple WNW 133.89'
50" Cherry NW 80.41'
CL Street Sign SE 29.41'
20" Cherry SE 50.30'
10" Pine SSE 61.95'

B. Description of corner evidence found and/or method applied in restoring or reestablishing corner:

I-3

Found cast iron monument in monument box and accepted it as a careful and faithful perpetuation of the position of the original corner

50" Maple WNW 133.89'
CL Street Sign SE 29.41'
10" Pine SSE 61.95'


C. Description of monument for corner and accessories established to perpetuate locating the position of the corner:

I-3

C.I.M. in monument box

AZ - Michigan State Grid Direction

O.C. Remon tag & nail in SW Side 12" Pine	AZ. 130°24'	63.31'
O.C. Remon tag & nail in NE Side 12" Pine	AZ. 318°13'	80.71'
Found nail and cap No. 14091 NW Side 8" Pine	AZ. 43°38'	81.14'
O.C. Remon tag & nail in SE Side 8" Pine	AZ. 230°38'	73.49'

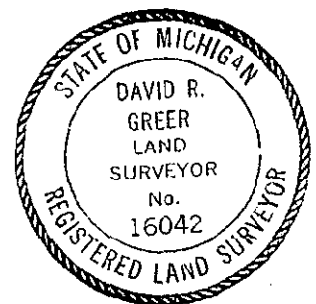

signed by David R. Greer

Date SEPT. 15, 1993

Surveyor's Michigan License No. 16042