

SURVEY & REMONUMENTATION

DEC 01 1993

COMMISSION
For corners in

**OTTAWA COUNTY REMONUMENTATION
LAND CORNER RECORDATION CERTIFICATE
Filing Requirement of Act 74, Mich. P.A. 1970**

RECORDED
93 NOV 11 AM 11:56
Phyllis Carlsson
REGISTER OF DEEDS
OTTAWA COUNTY, MI

Ottawa (County)	Located In:	Corner Code #
1. Public Land Survey	T <u>6N</u> R <u>16W</u>	<u>I-4 (W 1/4 Sec. 11)</u>
	T _____ R _____	<u>Port Sheldon Twp.</u>
	T _____ R _____	_____
	T _____ R _____	_____
2. Property Controlling in Section	S _____ T _____ R _____	_____
	S _____ T _____ R _____	_____
3. Miscellaneous Property in Sec.	S _____ T _____ R _____	_____
	S _____ T _____ R _____	_____

Register of Deeds Stamp & File Number

4. Lot No. _____, Recorded Plat _____
5. Private Claims _____

I, David R. Greer, in a field survey on September 13, 19 93, do hereby certify that under requirements of P.A. 74, Michigan P.A. of 1970, the corner points mentioned in lines 1 and 2 above were in conformance with regulations and rules therefore as required in the current manual of survey instructions of the United States Department of the Interior, Bureau of Land Management or by a decree of a Court of Law and/or that the corner points mentioned in lines 3, 4 and 5 above were in conformance with the rules of the Michigan Board of Land Surveyors or by a Decree of a Court of Law; established, re-established, monumented, re-monumented, recovered, found as expressed below:

NOTE: Not more than 4 corners, all in the same town and range, may be recorded on this certificate.

	A	B	C	D	E	F	G	H	I	J	K	L	M
2	6	5	4	3	2	1							
3													
4	7	8	9	10	11	12							
5													
6	18	17	16	15	14	13							
7													
8	19	20	21	22	23	24							
9													
10	30	29	28	27	26	25							
11													
12	31	32	33	34	35	36							
13													

A. Description of original monument and accessories and/or subsequent restoration:

Recorded in Liber 1 Page 795, Dec. 8, 1972

I-4

Found "T" Iron in Monument Box

Guy Pole	NE	41.60'
24" Maple	SE	47.61'
Power Pole	SW	40.03'

B. Description of corner evidence found and/or method applied in restoring or reestablishing corner:

I-4

Found "T" iron in monument box over iron pipe and accepted it as a careful and faithful perpetuation of the position of the original corner

Guy Pole	NE	41.60'
Power Pole	SW	40.03'


C. Description of monument for corner and accessories established to perpetuate locating the position of the corner:

I-4

Raised C.I.M. in monument box with O.C. Remonument Iron & Cap.

AZ - Michigan State Grid Direction

O.C. Remon tag & nail in NE Side 8" Pine	AZ.	224°19'	68.16'
O.C. Remon tag & nail in SE Side 24" Maple	AZ.	299°32'	94.08'
NW Cor House Foundation	AZ.	25°29'	184.87'
NW Cor House Foundation	AZ.	133°05'	115.07'

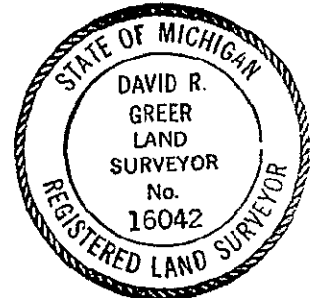

Signed by David R. Greer Date SEPT. 13, 1993

Surveyor's Michigan License No. 16042