

**SURVEY & REMONUMENTATION**

DEC 01 1993

COMMISSION

**OTTAWA COUNTY REMONUMENTATION  
LAND CORNER RECORDATION CERTIFICATE  
Filing Requirement of Act 74, Mich. P.A. 1970**

RECORDED

93 NOV 11 AM 11:56

*Robert Williams*  
REGISTER OF DEEDS  
OTTAWA COUNTY, MI

For corners in

Ottawa (County)	Located In:	Corner Code #
1. Public Land Survey	T <del>6N</del> R <del>16W</del>	1-5 (SW <del>11</del> Sec.-11) Part Sheldon Twp:
	T _____ R _____	_____
	T _____ R _____	_____
	T _____ R _____	_____
2. Property Controlling in Section	S _____ T _____ R _____	_____
	S _____ T _____ R _____	_____
3. Miscellaneous Property in Sec.	S _____ T _____ R _____	_____
	S _____ T _____ R _____	_____
4. Lot No. _____, Recorded Plat _____		
5. Private Claims _____		

Register of Deeds Stamp & File Number

I, David R. Greer, in a field survey on September 15, 19 93, do hereby certify that under requirements of P.A. 74, Michigan P.A. of 1970, the corner points mentioned in lines 1 and 2 above were in conformance with regulations and rules therefore as required in the current manual of survey instructions of the United States Department of the Interior, Bureau of Land Management or by a decree of a Court of Law and/or that the corner points mentioned in lines 3, 4 and 5 above were in conformance with the rules of the Michigan Board of Land Surveyors or by a Decree of a Court of Law; established, re-established, monumented, re-monumented, recovered, found as expressed below:

**NOTE: Not more than 4 corners, all in the same town and range, may be recorded on this certificate.**

	A	B	C	D	E	F	G	H	I	J	K	L	M
2	6	5	4	3	2	1							
3													
4	7	8	9	10	11	12							
5													
6	18	17	16	15	14	13							
7													
8	19	20	21	22	23	24							
9													
10	30	29	28	27	26	25							
11													
12	31	32	33	34	35	36							
13													

A. Description of original monument and accessories and/or subsequent restoration:

Recorded in Liber 1 Page 745, December 8, 1972

1-5

Set Cast Iron Monument

Power Pole	SSE	30.59'
NE Cor of Church	SW	55.12'
CL Street Sign		59.09'
Power Pole	NW	77.06'

B. Description of corner evidence found and/or method applied in restoring or reestablishing corner:

1-5

Found cast iron monument in monument box and accepted it as a careful and faithful perpetuation of the position of the original corner

Power Pole	SSE	30.59'
CL Street Sign		59.09'
Power Pole	NW	77.06'


C. Description of monument for corner and accessories established to perpetuate locating the position of the corner:

1-5

C.I.M. in monument box

AZ - Michigan State Grid Direction

CL Gravel Roads W, N, E	AZ.	335°15'	32.50'
O.C. Remon tag & nail in NW Side 14" Pine	AZ.	41°48'	86.79'
O.C. Remon tag & nail in NW Side 12" Aspen	AZ.	132°45'	62.86'
O.C. Remon tag & nail in N Side 8" Pine	AZ.	248°52'	117.23
O.C. Remon tag & nail in NE Side 10" Pine	AZ.	304°03'	127.10'

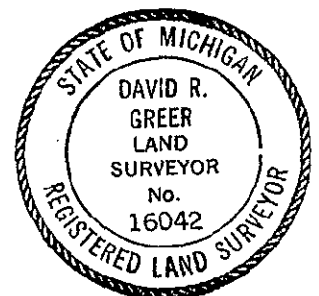

signed by

*David R. Greer*

Date

Sept. 15, 1993

Surveyor's Michigan License No.

16042

FORM APPROVED BY MICHIGAN STATE BOARD OF LAND SURVEYORS, JAN. 28, 1971  
REVISED MAY 14, 1975  
REVISED JAN., 1983