

# SURVEY & REMONUMENTATION

OTTAWA COUNTY REMONUMENTATION

RECORDED

APR 25 1995

LAND CORNER RECORDATION CERTIFICATE  
Filing Requirement of Act 74, Mich. P.A. 1970

94 DEC -8 PM 12:31

For corners in **COMMISSION**  
Ottawa  
(County)

Located In:

Corner Code #

- |                                    |   |           |   |            |                       |
|------------------------------------|---|-----------|---|------------|-----------------------|
| 1. Public Land Survey              | T | <u>6N</u> | R | <u>16W</u> | I-6 (W1/4 Cor Sec 14) |
|                                    | T |           | R |            | Port Sheldon Twp.     |
|                                    | T |           | R |            |                       |
|                                    | T |           | R |            |                       |
| 2. Property Controlling in Section | S |           | T | R          |                       |
|                                    | S |           | T | R          |                       |
| 3. Miscellaneous Property in Sec.  | S |           | T | R          |                       |
|                                    | S |           | T | R          |                       |

*Dorothy Redman*  
REGISTER OF DEEDS  
OTTAWA COUNTY, MI

Register of Deeds Stamp & File Number

4. Lot No. \_\_\_\_\_, Recorded Plat \_\_\_\_\_  
5. Private Claims \_\_\_\_\_

	A	B	C	D	E	F	G	H	I	J	K	L	M
2	6	5	4	3	2	1							
3													
4	7	8	9	10	11	12							
5													
6	18	17	16	15	14	13							
7													
8	19	20	21	22	23	24							
9													
10	30	29	28	27	26	25							
11													
12	31	32	33	34	35	36							
13													

John P. Clapp in a field survey on November 17, 1994,  
do hereby certify that under requirements of P.A. 74, Michigan P.A. of 1970, the corner points mentioned in lines 1 and 2 above were in conformance with regulations and rules therefore as required in the current manual of survey instructions of the United States Department of the Interior, Bureau of Land Management or by a decree of a Court of Law and/or that the corner points mentioned in lines 3, 4 and 5 above were in conformance with the rules of the Michigan Board of Land Surveyors or by a Decree of a Court of Law; established, re-established, monumented, re-monumented, recovered, found as expressed below:

**NOTE: Not more than 4 corners, all in the same town and range, may be recorded on this certificate.**

1. Description of original monument and accessories and/or subsequent restoration:

- |  |  |
|--|--|
| <p>I-6<br/>Gov't Land Office Survey Notes<br/>May 1832 - Surveyor, Calvin Britain<br/>Post<br/>18" Hemlock S51°E 10 links<br/>10" Beech S70°W 18 links</p> | <p>I-6<br/>Recorded in Liber 2, Page 285<br/>August 7, 1973<br/>Found 3/4" Shaft and Wood Stake<br/>30" Twin Balsam N42°W 11.51'<br/>14" Balsam N25°E 32.25'<br/>14" Balsam S55°E 26.05'<br/>30" Twin Maple E 38.53'<br/>18" Beech NE 43.17'</p> |
|--|--|

2. Description of corner evidence found and/or method applied in restoring or reestablishing corner:


- I-6  
Found 3/4" shaft and accepted it as a careful and faithful perpetuation of the position of the original corner  
Found Nail in SE Side 22" Twin Balsam AZ. 322° 11.56'  
Found Nail & Tag in W Side 30" Twin Maple AZ. 90° 38.44'

PA. 345 OTTAWA COUNTY  
PEER APPROVED 11/21/94

*Redmond D. Medwed*

3. Description of monument for corner and accessories established to perpetuate locating the position of the corner:

- I-6  
Set Ottawa County Remon Iron & Cap  
O.C. Remon tag & nail in S Side 20" Balsam AZ. 123° 26.36'  
O.C. Remon tag & nail in W Side 16" Maple AZ. 193° 50.49'  
O.C. Remon tag & nail in S Side 12" Maple AZ. 277° 33.10'  
O.C. Remon tag & nail in NE Side 22" Tw Balsam AZ. 322° 12.28'

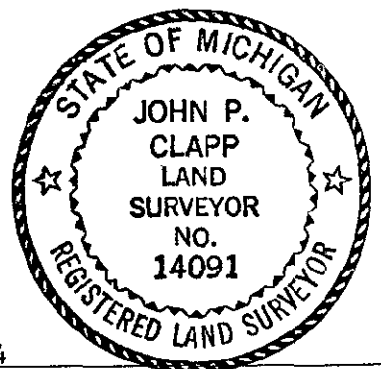

Signed by John P. Clapp Date Nov. 18, 1994

Surveyor's Michigan License No. 14091

FORM APPROVED BY MICHIGAN STATE BOARD OF LAND SURVEYORS, JAN. 28, 1971  
REVISED MAY 14, 1975  
REVISED JAN., 1983