

# SURVEY & REMONUMENTATION

APR 25 1995

OTTAWA COUNTY REMONUMENTATION

RECORDED

LAND CORNER RECORDATION CERTIFICATE

94 DEC -8 PM 12:31

Filing Requirement of Act 74, Mich. P.A. 1970

COMMISSION

or corners in

*Richard Robinson*  
REGISTER OF DEEDS  
OTTAWA COUNTY, MI

Ottawa (County)	Located In:	Corner Code #
Public Land Survey	T <u>6N</u> R <u>16W</u>	<u>1-8 (W1/4 Cor. Sec 23)</u>
	T _____ R _____	<u>Port Sheldon Twp.</u>
	T _____ R _____	_____
	T _____ R _____	_____
Property Controlling in Section	S _____ T _____ R _____	_____
Miscellaneous	S _____ T _____ R _____	_____
Property in Sec.	S _____ T _____ R _____	_____

Register of Deeds Stamp & File Number

Lot No. \_\_\_\_\_, Recorded Plat \_\_\_\_\_  
Private Claims \_\_\_\_\_

John P. Clapp, in a field survey on November 15, 19 94, hereby certify that under requirements of P.A. 74, Michigan P.A. of 1970, the corner points mentioned in lines 1 and 2 above were in conformance with regulations and rules therefore as required in the current manual of survey instructions of the United States Department of the Interior, Bureau of Land Management or by a decree of a Court of Law and/or that the corner points mentioned in lines 3, 4 and 5 above were in conformance with the rules of the Michigan Board of Land Surveyors or by a Decree of a Court of Law; established, re-established, monumented, re-monumented, recovered, found as pressed below:

	A	B	C	D	E	F	G	H	I	J	K	L	M
2	6	5	4	3	2	1							
3													
4	7	8	9	10	11	12							
5													
6	18	17	16	15	14	13							
7													
8	19	20	21	22	23	24							
9													
10	30	29	28	27	26	25							
11													
12	31	32	33	34	35	36							
13													

**NOTE: Not more than 4 corners, all in the same town and range, may be recorded on this certificate.**

Description of original monument and accessories and/or subsequent restoration:

I-8 Govt Land Office Survey Notes May 1832, Surveyor Calvin Britain Post 18" W. Ash      N38°W   4 links	I-8 Recorded in Liber 2 Page 311, Sept 13, 1973 Fd Iron in Mon. Box Power Pole      SE      37.03' Guy Pole      NE      52.83' Light Pole      NNE      30.17'	I-8 Recorded in Liber 3 Page 364, July 6, 1979 Iron in Mon. Box Power Pole      SE      36.95' CL St. Sign      NE      38.40' Power Pole      NE      30.05' 12" Cherry      NW      56.67'
--	---	---

Description of corner evidence found and/or method applied in restoring or reestablishing corner:


I-8 Found cast iron monument and accepted it as a careful and faithful perpetuation of the position of the original corner		
Found Nail in 26" Beech	AZ 348°	98.03'
Found Nail in 19" Maple	AZ 50°	43.07'
Found Nail in Light Pole	AZ 24°	30.40'
Found Nail & Tag in Lt. Pole	AZ 24°	30.05'
Found Nail in Power Pole	AZ 139°	37.61'
Found Nail & Tag in P. Pole	AZ 139°	36.98'
CL Street Sign	AZ 44°	38.30'

P.A. 345 OTTAWA COUNTY  
PEER APPROVED 11/21/94

*Arday P. Nedwell*

Description of monument for corner and accessories established to perpetuate locating the position of the corner:

I-8 Found C.I.M. in monument box		
O.C. Remon tag & nail in NW Side 19" Maple	AZ.      50°	43.13'
O.C. Remon tag & nail in E Side 26" Beech	AZ.      349°	97.76'
O.C. Remon tag & nail in SW Side P. Pole	AZ.      139°	37.40'
O.C. Remon tag & nail in NE Side P. Pole	AZ.      309°	64.45'

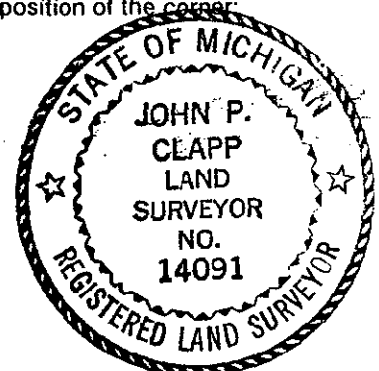

Signed by John P. Clapp Date November 16, 1994  
Surveyor's Michigan License No. 14091

I-8

Recorded in Liber 5, Page 78

December 20, 1983

Set Cast Iron Monument

20" Beech	NNW	98.01'
Light Pole	NNE	30.40'
12" Maple	NE	43.05'
Power Pole	SE	37.60'

1983  
# 2000  
