

SURVEY & REMONUMENTATION

OCT 24 1994

COMMISSION

OTTAWA COUNTY REMONUMENTATION

LAND CORNER RECORDATION CERTIFICATE
Filing Requirement of Act 74, Mich. P.A. 1970

RECORDED

94 OCT -7 PM 12:32

Phyllis Sullivan
 REGISTER OF DEEDS
 OTTAWA COUNTY, MI

For corners in

<u>Ottawa</u> (County)	Located In:	Corner Code #
1. Public Land Survey	T <u>6N</u> R <u>16W</u>	<u>I-12 (W 1/4 Cor. 35)</u>
	T _____ R _____	<u>Port-Sheldon Twp.</u>
	T _____ R _____	_____
	T _____ R _____	_____
2. Property Controlling in Section	S _____ T _____ R _____	_____
	S _____ T _____ R _____	_____
3. Miscellaneous Property in Sec.	S _____ T _____ R _____	_____
	S _____ T _____ R _____	_____
4. Lot No. _____, Recorded Plat _____		
5. Private Claims _____		

Register of Deeds Stamp & File Number

I, Gerald T. Ford, in a field survey on April 1, 19 94, do hereby certify that under requirements of P.A. 74, Michigan P.A. of 1970, the corner points mentioned in lines 1 and 2 above were in conformance with regulations and rules therefore as required in the current manual of survey instructions of the United States Department of the Interior, Bureau of Land Management or by a decree of a Court of Law and/or that the corner points mentioned in lines 3, 4 and 5 above were in conformance with the rules of the Michigan Board of Land Surveyors or by a Decree of a Court of Law; established, re-established, monumented, re-monumented, recovered, found as expressed below:

A	B	C	D	E	F	G	H	I	J	K	L	M
2	6	5	4	3	2	1						
3												
4	7	8	9	10	11	12						
5												
6	18	17	16	15	14	13						
7												
8	19	20	21	22	23	24						
9												
10	30	29	28	27	26	25						
11												
12	31	32	33	34	35	36						
13												

NOTE: Not more than 4 corners, all in the same town and range, may be recorded on this certificate.

A. Description of original monument and accessories and/or subsequent restoration:

I-12	I-12		
Government Land Office Survey Notes	Recorded in Liber 4 Page 337		
1832 - Surveyor, Calum Britian	Cast Iron Monument		
Post	Power Pole	N	70.28'
12" Beech N81°W 15 links	10" Red Pine	N	12.43'
6" Hemlock S61°E 12 links	10" Red Pine	E	57.79'
	CL Butternut Dr.	NE	103.00'

B. Description of corner evidence found and/or method applied in restoring or reestablishing corner:

I-12
 Found cast iron monument and accepted it as a careful and faithful perpetuation of the position of the original corner
 Found nail in 10" red pine N' 12.41'
 CL Butternut Drive NE 103.00' ±


C. Description of monument for corner and accessories established to perpetuate localing the position of the corner:

P.A. 345 OTTAWA COUNTY

PEER APPROVED 6/20/94

<i>Gordon D. Hedewell</i>		
AZ. 229°	60.45'	
AZ. 258°	32.97'	
AZ. 349°	13.11'	
AZ. 282°	40.36'	

- I-12
- Cast Iron Monument
- O.C. Remon tag & nail in E face 24" Oak
- O.C. Remon tag & nail in N face 22" White Pine
- O.C. Remon tag & nail in E face 14" Red Pine
- O.C. Remon tag & nail in E face 24" White Pine

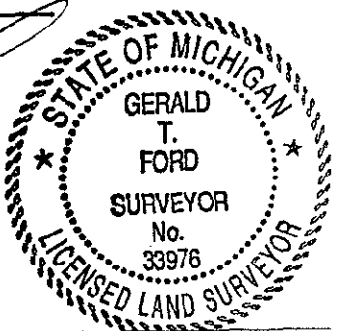

Signed by Gerald T. Ford Date July 13, 1994

Surveyor's Michigan License No. 33976