

**Ottawa County Remonumentation
LAND CORNER RECORDATION CERTIFICATE**
Filing Requirement of Act 74, Mich. P.A. 1970

RECORDED

96 DEC 18 PM 4:56

Richard R. Williams
REGISTER OF DEEDS
OTTAWA COUNTY, MI

For corners in	Ottawa (County)	Located In:	Corner Code #
1. Public Land Survey	T 6N R 16W	J-1	
	T R	Port Sheldon	
	T R	Twp.	
	T R	NORTH 1/4 CORNER	
2. Property Controlling in Section	S T R	SECTION 2	
	S T R		
3. Miscellaneous Property in Sec.	S T R		
	S T R		

Register of Deeds Stamp & File Number

4. Lot No. _____, Recorded Plat _____
5. Private Claims _____

	A	B	C	D	E	F	G	H	I	J	K	L	M
1													
2	6	5	4	3	2	1							
3													
4	7	8	9	10	11	12							
5													
6	18	17	16	15	14	13							
7													
8	19	20	21	22	23	24							
9													
10	30	29	28	27	26	25							
11													
12	31	32	33	34	35	36							
13													

I, Steven Lampen, in a field survey on Nov. 7 1996, do hereby certify that under requirements of P.A. 74, Michigan P.A. of 1970, the corner points mentioned in lines 1 and 2 above were in conformance with regulations and rules therefore as required in the current manual of survey instructions of the United States Department of the Interior, Bureau of Land Management or by a decree of a Court of Law and/or that the corner points mentioned in lines 3, 4 and 5 above were in conformance with the rules of the Michigan Board of Land Surveyors or by a Decree of a Court of Law; established, re-established, monumented, re-monumented, recovered, found as expressed below:

NOTE: Not more than 4 corners, all in the same town and range, may be recorded on this certificate.

A. Description of original monument and accessories and/or subsequent restoration:

J-1 GLO-corner not set by GLO survey	LCRC L2 P755-1975 Found 1/2" rod SE 8" pine 30.93 NE 8" maple 36.19 NNE 8" pine 18.90	LCRC L5 P66 - 1983 Found broken concrete monument 18" pepperidge NE 82.40 10" maple cluster NE 46.13 12" pine SE 30.92 Grand Haven Twp cor E 23.70
LCRC L6 P137 - 1991 Cast iron monument East 23.60 to Grand Haven Twp corner NE 67.89 to nail West side 8" maple ENE 76.90 to nail North side 12" pine ESE 76.25 to nail North side 10" poplar SE 38.05 to nail West side post		LCRC L6 P68-1990 Witnesses recorded for J-1 T6N, R16W actually fit J-13, T7N, R16W

B. Description of corner evidence found and/or method applied in restoring or reestablishing corner:

J-1
Found cast iron monument in monument box
East 23.60 to Grand Haven Twp corner
NE 67.89 to nail West side 8" maple
ENE 76.90 to nail North side 12" pine
ESE 76.25 to nail North side 10" poplar
SE 38.05 to nail West side post

P.A. 345 OTTAWA COUNTY
PEER APPROVED 12-9-96


S. D. N.

This corner not monumented by the original GLO survey. This monument is accepted as the best available evidence of the position of the corner. Established corner at the intersection of the N & S 1/4 line of Section 2 with the South line of Section 35 T7N R16W

C. Description of monument for corner and accessories established to perpetuate locating the position of the corner:

J-1 Established corner at the intersection of the N & S 1/4 line of Section 2 with the South line of Section 35 T7N, R16W. Az.= Michigan State Plane Grid Direction.

Centerline east and west asphalt road pavement	N	0
Cast iron monument in monument box	359°07'	0.23
Mid-point I-1 and K-1	270°51'	7.10
J-13 T7N R16W = cast iron monument in monument box	90°51'	23.59
Nail SW side 8" cherry	146°13'	45.90
Remon tag NW side 12" pine	56°23'	77.03
Nail NW side 12" poplar	45°29'	72.96
Nail NE side 10" poplar	137°37'	54.81
West edge woods to south	East	23.59
Centerline ditch to North and West edge woods to north	East	44

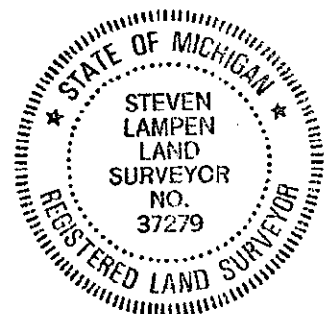

Signed by Steven Lampen Date November 11, 1996

Surveyor's Michigan License No. 37279

FORM APPROVED BY MICHIGAN STATE BOARD OF LAND SURVEYORS, JAN. 28, 1971
REVISED MAY 14, 1976
REVISED JAN., 1983
ADAPTED FOR WORD PROCESSING MARCH, 1983

