

DEC 01 1993

COMMISSION

OTTAWA COUNTY REMONUMENTATION  
LAND CORNER RECORDATION CERTIFICATE  
Filing Requirement of Act 74, Mich. P.A. 1970

RECORDED  
93 NOV 11 AM 11:56


*Phyllis Kullback*  
REGISTER OF DEEDS  
OTTAWA COUNTY, MI

For corners in

<u>Ottawa</u> (County)	Located In:	Corner Code #
1. Public Land Survey	T <u>6N</u> R <u>16W</u>	<u>J-5 (S 1/4 Sec 11)</u>
	T _____ R _____	<u>Port Sheldon Twp.</u>
	T _____ R _____	_____
	T _____ R _____	_____
2. Property Controlling in Section	S _____ T _____ R _____	_____
	S _____ T _____ R _____	_____
3. Miscellaneous Property in Sec.	S _____ T _____ R _____	_____
	S _____ T _____ R _____	_____
4. Lot No. _____, Recorded Plat _____		
5. Private Claims _____		

Register of Deeds Stamp & File Number

I, David R. Greer, in a field survey on October 8, 19 93, do hereby certify that under requirements of P.A. 74, Michigan P.A. of 1970, the corner points mentioned in lines 1 and 2 above were in conformance with regulations and rules therefore as required in the current manual of survey instructions of the United States Department of the Interior, Bureau of Land Management or by a decree of a Court of Law and/or that the corner points mentioned in lines 3, 4 and 5 above were in conformance with the rules of the Michigan Board of Land Surveyors or by a Decree of a Court of Law; established, re-established, monumented, re-monumented, recovered, found as expressed below:

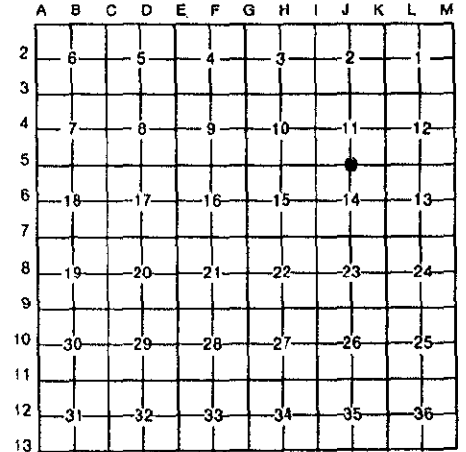

NOTE: Not more than 4 corners, all in the same town and range, may be recorded on this certificate.

A. Description of original monument and accessories and/or subsequent restoration:

Recorded in Liber 1 Page 795 Dec. 8, 1972

J-5

Set cast iron monument on line midway between SE & SW corners

- 6" Cherry S 55.38'
- 12" Pine NE 40.30'
- 10" Pine NNE 55.01'
- Power Pole NW 73.62'

B. Description of corner evidence found and/or method applied in restoring or reestablishing corner:

J-5

Found cast iron monument in monument box and accepted it as a careful and faithful perpetuation of the position of the original corner

- 6" Cherry S 55.38'
- 12" Pine NE 40.30'


C. Description of monument for corner and accessories established to perpetuate locating the position of the corner:

J-5

C.I.M. in monument box

AZ - Michigan State Grid Direction

- O.C. Remon tag & nail in E Side 12" Pine AZ. 184°16' 49.53'
  - O.C. Remon tag & nail in W Side 10" Pine AZ. 221°23' 73.85'
  - O.C. Remon tag & nail in SW Side 12" Pine AZ. 309°21' 101.57'
  - O.C. Remon tag & nail in NW Side 10" Pine AZ. 67°52' 41.46'
- CL Gravel Roads, W, N, E

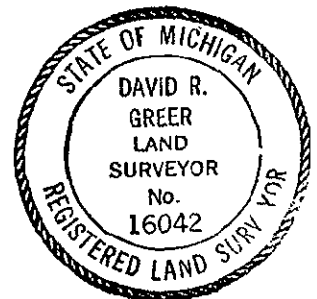

signed by

*David R. Greer*

Date

OCT. 8, 1993

Surveyor's Michigan License No. 16042