

SURVEY & REMONUMENTATION

DEC 01 1993

**OTTAWA COUNTY REMONUMENTATION
LAND CORNER RECORDATION CERTIFICATE
Filing Requirement of Act 74, Mich. P.A. 1970**

RECORDED

93 NOV 11 AM 11:56

COMMISSION

For corners in

David R. Greer
REGISTER OF DEEDS
OTTAWA COUNTY, MI

| Corner Code # | Located In: | Corner Code # |
|------------------------------------|----------------------------------|---------------------|
| 1. Public Land Survey | T 6N R 16W | J-11 (N 1/4 Sec 35) |
| | T _____ R _____ | Port Sheldon Twp. |
| | T _____ R _____ | |
| | T _____ R _____ | |
| 2. Property Controlling in Section | S _____ T _____ R _____ | |
| | S _____ T _____ R _____ | |
| 3. Miscellaneous Property in Sec. | S _____ T _____ R _____ | |
| | S _____ T _____ R _____ | |

Register of Deeds Stamp & File Number

4. Lot No. _____, Recorded Plat _____
5. Private Claims _____

| | A | B | C | D | E | F | G | H | I | J | K | L | M |
|----|----|---|----|---|----|---|----|---|----|---|----|---|---|
| 2 | 6 | | 5 | | 4 | | 3 | | 2 | | 1 | | |
| 3 | | | | | | | | | | | | | |
| 4 | 7 | | 8 | | 9 | | 10 | | 11 | | 12 | | |
| 5 | | | | | | | | | | | | | |
| 6 | 18 | | 17 | | 16 | | 15 | | 14 | | 13 | | |
| 7 | | | | | | | | | | | | | |
| 8 | 19 | | 20 | | 21 | | 22 | | 23 | | 24 | | |
| 9 | | | | | | | | | | | | | |
| 10 | 30 | | 29 | | 28 | | 27 | | 26 | | 25 | | |
| 11 | | | | | | | | | | | | | |
| 12 | 31 | | 32 | | 33 | | 34 | | 35 | | 36 | | |
| 13 | | | | | | | | | | | | | |

I, David R. Greer, in a field survey on September 13, 19 1993, do hereby certify that under requirements of P.A. 74, Michigan P.A. of 1970, the corner points mentioned in lines 1 and 2 above were in conformance with regulations and rules therefore as required in the current manual of survey instructions of the United States Department of the Interior, Bureau of Land Management or by a decree of a Court of Law and/or that the corner points mentioned in lines 3, 4 and 5 above were in conformance with the rules of the Michigan Board of Land Surveyors or by a Decree of a Court of Law; established, re-established, monumented, re-monumented, recovered, found as expressed below:

NOTE: Not more than 4 corners, all in the same town and range, may be recorded on this certificate.

A. Description of original monument and accessories and/or subsequent restoration:

Recorded in Liber 5, Page 308, March 18, 1988

J-11

Cast iron monument

| | | |
|----------------|----|-------|
| 6" Maple | SW | 46.40 |
| 8" Poplar | SE | 73.91 |
| 9" Poplar | NW | 73.08 |
| Fence to North | E | 16' |

B. Description of corner evidence found and/or method applied in restoring or reestablishing corner:

J-11

Found cast iron monument in monument box and accepted it as a careful and faithful perpetuation of the position of the original corner

| | | |
|----------------|----|-------|
| 6" Maple | SW | 46.40 |
| 8" Poplar | SE | 73.91 |
| 9" Poplar | NW | 73.08 |
| Fence to North | E | 16' |


C. Description of monument for corner and accessories established to perpetuate locating the position of the corner:

J-11

Raised C.I.M. in monument box with O.C. Remonumentation Iron & Cap

AZ - Michigan State Grid Direction

| | | |
|--|-------------|--------|
| O.C. Remon tag & nail in SW Side 8" Cherry | AZ. 148°35' | 82.36' |
| O.C. Remon tag & nail in SE Side 8" Cherry | AZ. 202°55' | 46.41' |
| O.C. Remon tag & nail in NE Side 6" Poplar | AZ. 309°55' | 83.85' |
| O.C. Remon tag & nail in W Side 6" Maple | AZ. 355°54' | 66.53' |
| O.C. Remon tag & nail in W Side 6" Poplar | AZ. 38°25' | 71.64' |

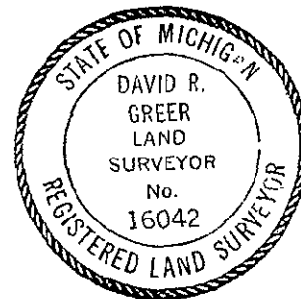

Signed by David R. Greer Date SEPT. 13, 1993

Surveyor's Michigan License No. 16042