

DEC 01 1993

COMMISSIONER

OTTAWA COUNTY REMONUMENTATION
LAND CORNER RECORDATION CERTIFICATE
Filing Requirement of Act 74, Mich. P.A. 1970

RECORDED

93 NOV 11 AM 11:56

Deborah R. Ballman
REGISTER OF DEEDS
OTTAWA COUNTY, MI


For corners in

<u>Ottawa</u> (County)	Located In:	Corner Code #
1. Public Land Survey	T <u>6N</u> R <u>16W</u>	<u>K-3 (NE Sec 11)</u>
	T _____ R _____	<u>Port Sheldon Twp.</u>
	T _____ R _____	_____
	T _____ R _____	_____
2. Property Controlling in Section	S _____ T _____ R _____	_____
	S _____ T _____ R _____	_____
3. Miscellaneous Property in Sec.	S _____ T _____ R _____	_____
	S _____ T _____ R _____	_____

Register of Deeds Stamp & File Number

4. Lot No. _____, Recorded Plat _____
5. Private Claims _____

I, David R. Greer, in a field survey on October 8, 19 93, do hereby certify that under requirements of P.A. 74, Michigan P.A. of 1970, the corner points mentioned in lines 1 and 2 above were in conformance with regulations and rules therefore as required in the current manual of survey instructions of the United States Department of the Interior, Bureau of Land Management or by a decree of a Court of Law and/or that the corner points mentioned in lines 3, 4 and 5 above were in conformance with the rules of the Michigan Board of Land Surveyors or by a Decree of a Court of Law; established, re-established, monumented, re-monumented, recovered, found as expressed below.

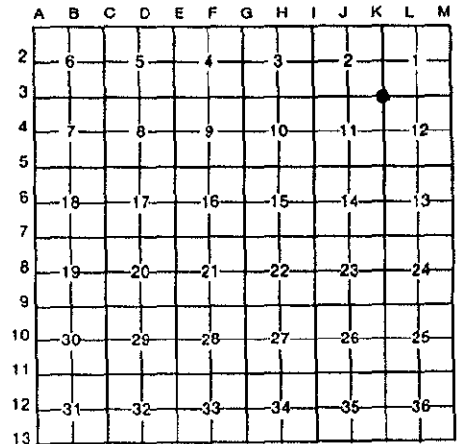

NOTE: Not more than 4 corners, all in the same town and range, may be recorded on this certificate.

A. Description of original monument and accessories and/or subsequent restoration:

Recorded in Liber 1 Page 795 Dec. 8, 1972

K-3
3/4" Iron Pipe Found

16" Maple	NE	47.17'
Power Pole	NE	81.03'
CL Street Sign		34.17'
Power Pole	SW	41.44'
10" Pine	SE	76.72'

Recorded in Liber 4 Page 162, April 1, 1981

K-3		
Set Cast Iron Monument		
Corner Fence Post	NW	47.67'
22" Maple	NE	47.28'
Telephone Pedestal	SW	42.02'
Street Sign	SE	34.13'

B. Description of corner evidence found and/or method applied in restoring or reestablishing corner:

K-3
Found cast iron monument in monument box.

Corner Fence Post	NW	47.67	16" Maple	NE	47.17'
22" Maple	NE	47.28	Power Pole	NE	81.03'
Street Sign	SE	34.13'	CL Street Sign		34.17'
			Power Pole	SW	41.44'
			10" Pine	SE	76.72'

C. Description of monument for corner and accessories established to perpetuate locating the position of the corner:

K-3
C.I.M. in monument box
AZ - Michigan State Grid Direction

NE Cor House Foundation	AZ.	249°14'	188.33'
O.C. Remon tag & nail in S Side 6" pine	AZ.	116°28'	88.95'
O.C. Remon tag & nail in SW Side 8" Pine	AZ.	152°16'	91.07'
O.C. Remon tag & nail in NW Side 10" Pine	AZ.	48°33'	118.56'



Signed by David R. Greer

Date Oct. 8, 1993

Surveyor's Michigan License No. 16042