

SURVEY & REMONUMENTATION

DEC 01 1993

COMMISSION

**OTTAWA COUNTY REMONUMENTATION
LAND CORNER RECORDATION CERTIFICATE
Filing Requirement of Act 74, Mich. P.A. 1970**

RECORDED

93 NOV 11 AM 11:56

Daphne D. Sullivan
REGISTER OF DEEDS
OTTAWA COUNTY, MI

For corners in

_____ Ottawa _____ (County)	Located In:	Corner Code #
1. Public Land Survey	T 6N R 16W	K-4 (E 1/4 Sec. 11)
	T _____ R _____	Port Sheldon Twp:
	T _____ R _____	_____
	T _____ R _____	_____
2. Property Controlling in Section	S _____ T _____ R _____	_____
	S _____ T _____ R _____	_____
3. Miscellaneous Property in Sec.	S _____ T _____ R _____	_____
	S _____ T _____ R _____	_____

Register of Deeds Stamp & File Number

4. Lot No. _____, Recorded Plat _____
5. Private Claims _____

I, David R. Greer, in a field survey on September 15, 19 93, do hereby certify that under requirements of P.A. 74, Michigan P.A. of 1970, the corner points mentioned in lines 1 and 2 above were in conformance with regulations and rules therefore as required in the current manual of survey instructions of the United States Department of the Interior, Bureau of Land Management or by a decree of a Court of Law and/or that the corner points mentioned in lines 3, 4 and 5 above were in conformance with the rules of the Michigan Board of Land Surveyors or by a Decree of a Court of Law; established, re-established, monumented, re-monumented, recovered, found as expressed below:

NOTE: Not more than 4 corners, all in the same town and range, may be recorded on this certificate.

	A	B	C	D	E	F	G	H	I	J	K	L	M
2	6	5	4	3	2	1							
3													
4	7	8	9	10	11	12							
5													
6	16	17	18	15	14	13							
7													
8	19	20	21	22	23	24							
9													
10	30	29	28	27	26	25							
11													
12	31	32	33	34	35	36							
13													

A. Description of original monument and accessories and/or subsequent restoration:

Recorded in Liber 1 on Page 647, Oct. 13, 1972

K-4

Found Steel Rod

18" Maple NE 71.88'
Power Pole NW 89.62'
14" Maple SW 54.81'

Recorded in Liber 6, Page 127, Jan. 28, 1991

K-4

30" Maple NW 57.32'
21" Maple NE 53.10'
16" Maple S 25.92'
27" Maple SW 55.48'

B. Description of corner evidence found and/or method applied in restoring or reestablishing corner:

K-4

Found cast iron monument in monument box and accepted it as a careful and faithful perpetuation of the position of the original corner.

18" Maple NE 71.88' 30" Maple NW 57.32'
Power Pole NW 89.62' 21" Maple NE 53.10'
14" Maple SW 54.81' 16" Maple S 25.92'
27" Maple SW 55.48'


C. Description of monument for corner and accessories established to perpetuate locating the position of the corner:

K-4

C.I.M. in monument box

AZ = Michigan State Grid Direction

O.C. Remon tag & nail in NE Side 8" Pine AZ. 139°07' 54.10'
O.C. Remon tag & nail in SE Side 24" Maple AZ. 61°30' 67.49'
O.C. Remon tag & nail in SW Side 18" Catalph AZ. 299°53' 71.76'
NE Cor House, Brick AZ. 214°16' 140.73

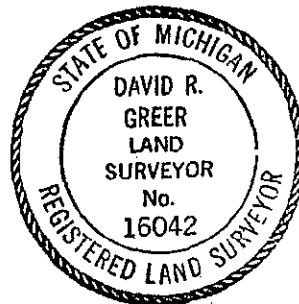

Signed by David R. Greer

Date SEPT. 15, 1993

Surveyor's Michigan License No. 16042