

SURVEY & REMONUMENTATION

DEC 01 1993

Commissioner

OTTAWA COUNTY REMONUMENTATION

LAND CORNER RECORDATION CERTIFICATE

Filing Requirement of Act 74, Mich. P.A. 1970

RECORDED

93 NOV 11 AM 11:56

Phyllis Robinson
REGISTER OF DEEDS
OTTAWA COUNTY, MI

For corners in

<u>Ottawa</u> (County)	Located In:	Corner Code #
1. Public Land Survey	T <u>6N</u> R <u>18W</u>	<u>K-5 (SE-Sec. 11)</u>
	T <u> </u> R <u> </u>	<u>Port-Sheldon-Twp.</u>
	T <u> </u> R <u> </u>	_____
	T <u> </u> R <u> </u>	_____
2. Property Controlling in Section	S <u> </u> T <u> </u> R <u> </u>	_____
	S <u> </u> T <u> </u> R <u> </u>	_____
3. Miscellaneous Property in Sec.	S <u> </u> T <u> </u> R <u> </u>	_____
	S <u> </u> T <u> </u> R <u> </u>	_____

Register of Deeds Stamp & File Number

4. Lot No. _____, Recorded Plat _____
5. Private Claims _____

	A	B	C	D	E	F	G	H	I	J	K	L	M
2	6	5	4	3	2	1							
3													
4	7	8	9	10	11	12							
5													
6	18	17	16	15	14	13							
7													
8	19	20	21	22	23	24							
9													
10	30	29	28	27	26	25							
11													
12	31	32	33	34	35	36							
13													

I, David R. Greer, in a field survey on September 15, 19 93, do hereby certify that under requirements of P.A. 74, Michigan P.A. of 1970, the corner points mentioned in lines 1 and 2 above were in conformance with regulations and rules therefore as required in the current manual of survey instructions of the United States Department of the Interior, Bureau of Land Management or by a decree of a Court of Law and/or that the corner points mentioned in lines 3, 4 and 5 above were in conformance with the rules of the Michigan Board of Land Surveyors or by a Decree of a Court of Law; established, re-established, monumented, re-monumented, recovered, found as expressed below.

NOTE: Not more than 4 corners, all in the same town and range, may be recorded on this certificate.

A. Description of original monument and accessories and/or subsequent restoration:


Recorded in Liber 1 Page 407 May 26, 1972
K-5
Found Iron Pipe
Nail in face of 12" White Oak NE 12.25'
Nail in face of 12" White Oak SW 7.49'
Nail in face of 12" Red Oak S 5.61'
Nail in face of 12" Red Oak S 25.90'
Nail in face of 10" Red Oak SE 22.07'

B. Description of corner evidence found and/or method applied in restoring or reestablishing corner:

K-5
Found iron pipe in monument box and accepted it as a careful and faithful perpetuation of the position of the original corner
Nail in face of 12" White Oak SW 7.49'
Nail in face of 12" Red Oak S 25.90'
Nail in face of 10" Red Oak SE 22.07'

C. Description of monument for corner and accessories established to perpetuate locating the position of the corner:

K-5
Replaced iron pipe in monument box with O.C. Remonument Iron & Cap
AZ - Michigan State Grid Direction
O.C. Remon tag & nail in NW Side 12" Oak AZ. 330° 31.59'
O.C. Remon tag & nail in S Side 8" Oak AZ. 86° 19.34'
O.C. Remon tag & nail in E Side 18" Oak AZ. 179° 26.35'
O.C. Remon tag & nail in S Side 12" Pine AZ. 269° 25.55'

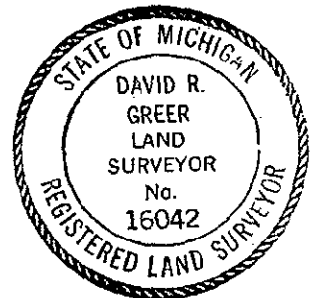

Signed by David R. Greer Date SEPT. 15, 1993
Surveyor's Michigan License No. 16042