

SURVEY & REMONUMENTATION

APR 25 1995

COMMISSION

For corners in

OTTAWA COUNTY REMONUMENTATION
LAND CORNER RECORDATION CERTIFICATE
Filing Requirement of Act 74, Mich. P.A. 1970

RECORDED

94 DEC -8 PM 12:31

D. J. ...
REGISTER OF DEEDS
OTTAWA COUNTY, MI

Ottawa (County)	Located In:	Corner Code #
1. Public Land Survey	T <u>6N</u> R <u>16W</u>	<u>K-6 (E1/4 Cor Sec 14)</u>
	T _____ R _____	<u>Port Sheldon Twp.</u>
	T _____ R _____	_____
	T _____ R _____	_____
2. Property Controlling in Section	S _____ T _____ R _____	_____
	S _____ T _____ R _____	_____
3. Miscellaneous Property in Sec.	S _____ T _____ R _____	_____
	S _____ T _____ R _____	_____

Register of Deeds Stamp & File Number

4. Lot No. _____, Recorded Plat _____
5. Private Claims _____

	A	B	C	D	E	F	G	H	I	J	K	L	M
2	6		5		4		3		2		1		
3													
4	7		8		9		10		11		12		
5													
6	18		17		16		15		14		13		
7													
8	19		20		21		22		23		24		
9													
10	30		29		28		27		26		25		
11													
12	31		32		33		34		35		36		
13													

I, John P. Clapp, in a field survey on November 15, 19 94, do hereby certify that under requirements of P.A. 74, Michigan P.A. of 1970, the corner points mentioned in lines 1 and 2 above were in conformance with regulations and rules therefore as required in the current manual of survey instructions of the United States Department of the Interior, Bureau of Land Management or by a decree of a Court of Law and/or that the corner points mentioned in lines 3, 4 and 5 above were in conformance with the rules of the Michigan Board of Land Surveyors or by a Decree of a Court of Law; established, re-established, monumented, re-monumented, recovered, found as expressed below:

NOTE: Not more than 4 corners, all in the same town and range, may be recorded on this certificate.

A. Description of original monument and accessories and/or subsequent restoration:

K-6	K-6
Govt Land Office Survey Notes	Recorded in Liber 1
May 1832, Surveyor Calvin Britain	Page 33, June 29, 1971
Post	Fd. Pinched Iron Pipe
6" Hemlock S39°E 9 links	P.P. N 24.31'
3" Hemlock N23°W 13 links	30" Maple NW 50.82'
	30" Maple NW 74.69'
	16" Tw Ash NE 79.41'
	NE Cor Gar SW 102.80'

K-6
Recorded in Liber 2
Page 685, Oct 22, 1971
Found Iron in Monument Box

36" Maple	NW	50.82'
30" Maple	NNW	74.61'
12" Maple	SW	59.37'
Power Pole	N	24.31'
Street Sign	N	27.10'
NE Cor Gar	SW	102.77'

B. Description of corner evidence found and/or method applied in restoring or reestablishing corner:

K-6
Found pinched pipe and accepted it as a careful and faithful perpetuation of the position of the original corner

40" Maple	AZ 331°	50.74'
40" Maple	AZ 342°	74.54'
Found P.K. W Side Power Pole	AZ 00°	24.77'
Street Sign	AZ 04°	27.28'


PA. 345 OTTAWA COUNTY
PEER APPROVED 11/21/94

Handwritten Signature

C. Description of monument for corner and accessories established to perpetuate locating the position of the corner:

K-6
Set O.C. Remon Cap & Iron in Monument Box

O.C. Remon tag & nail in W Side Power Pole	AZ.	00°	24.79'
O.C. Remon tag & nail in E Side 40" Maple	AZ.	331°	51.85'
O.C. Remon tag & nail in N Side 24" Maple	AZ.	252°	59.77'
O.C. Remon tag & nail in W Side 12" Maple	AZ.	144°	105.60'

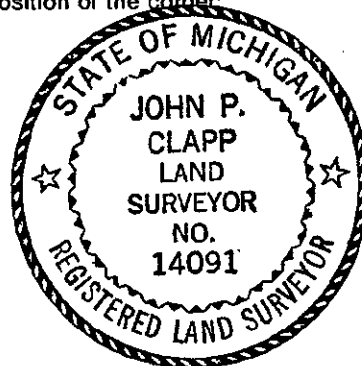

Signed by John P. Clapp Date Nov. 16, 1994

Surveyor's Michigan License No. 14091