

SURVEY & REMONUMENTATION

APR 25 1995

OTTAWA COUNTY REMONUMENTATION
LAND CORNER RECORDATION CERTIFICATE
Filing Requirement of Act 74, Mich. P.A. 1970

RECORDED

94 DEC -8 PM 12:31

COMMISSION

Deborah L. Robinson
REGISTER OF DEEDS
OTTAWA COUNTY, MI

For corners in

<u>Ottawa</u> <small>(County)</small>	Located In:	Corner Code #
1. Public Land Survey	T <u>6N</u> R <u>16W</u>	<u>K-8 (W 1/4 Cor. Sec. 24)</u>
	T _____ R _____	<u>Port Sheldon Twp.</u>
	T _____ R _____	_____
	T _____ R _____	_____
2. Property Controlling in Section	S _____ T _____ R _____	_____
	S _____ T _____ R _____	_____
3. Miscellaneous Property in Sec.	S _____ T _____ R _____	_____
	S _____ T _____ R _____	_____

Register of Deeds Stamp & File Number

4. Lot No. _____, Recorded Plat _____
5. Private Claims _____

John P. Clapp, in a field survey on November 14, 94

do hereby certify that under requirements of P.A. 74, Michigan P.A. of 1970, the corner points mentioned in lines 1 and 2 above were in conformance with regulations and rules therefore as required in the current manual of survey instructions of the United States Department of the Interior, Bureau of Land Management or by a decree of a Court of Law and/or that the corner points mentioned in lines 3, 4 and 5 above were in conformance with the rules of the Michigan Board of Land Surveyors or by a Decree of a Court of Law; established, re-established, monumented, re-monumented, recovered, found as expressed below:

NOTE: Not more than 4 corners, all in the same town and range, may be recorded on this certificate.

1. Description of original monument and accessories and/or subsequent restoration:

K-8 Gov't Land Office Survey Notes May 1832 - Surveyor, Calvin Britain Post 8" Beech S40°E 13 links 10" Hemlock N25°W 20 links	K-8 Recorded in Liber 2 Page 291, Aug. 28, 1973 Iron in Mon. Box Nail in Side T. Pole NW 39.82' Nail in Side Guy Pole SE 48.37' CL Street Sign NE 32.83'	K-8 Recorded in Liber 2 Page 311, Sept. 13, 1973 Found Angle Iron in Mon Box Guy Pole SE 48.00' CL St. Sign NE 32.85' Guy Pole NW 39.30'
---	--	--

NOTE: See reverse for additional recordings

2. Description of corner evidence found and/or method applied in restoring or reestablishing corner:

K-8
Found cast iron monument and accepted it as a careful and faithful perpetuation of the position of the original corner
Found Nail & Cap in SW Side Light Pole AZ. 320° 39.76'
Found Nail & Cap in SW Side Guy Pole AZ. 136° 48.41'
Street Sign AZ. 48° 48.72'


P.A. 345 OTTAWA COUNTY

PEER APPROVED 11/21/94

Arday P. Nedwell

3. Description of monument for corner and accessories established to perpetuate locating the position of the corner:

K-8
Found Ottawa County Cast Iron Monument
O.C. Remon tag & nail in SW Side Guy Pole AZ. 136° 48.42'
O.C. Remon tag & nail in SW Side Light Pole AZ. 320° 39.75'
O.C. Remon tag & nail in SE Side Twin 6" Poplar AZ. 240° 107.24'
"X" on Top of 12" CMP AZ. 59° 43.78'

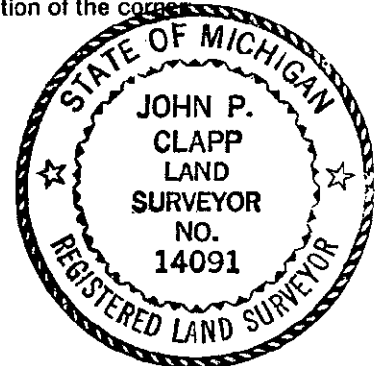

Signed by John P. Clapp *John P. Clapp* Date November 15, 1994

Surveyor's Michigan License No. 14091

OTTAWA

K-8

Recorded in Liber 5, Page 79, Dec. 20, 1983

Set Cast Iron Monument

Power Pole	NW	39.80'
Guy Pole	SW	48.38'
CL Street Sign	NE	41.00'
Power Pole	NNW	88.53'

RECORDED
INDEXED
JUN 11 1984
FBI - OTTAWA