

SURVEY & REMONUMENTATION

DEC 01 1993

COMMISSION

For corners in

OTTAWA COUNTY REMONUMENTATION LAND CORNER RECORDATION CERTIFICATE Filing Requirement of Act 74, Mich. P.A. 1970

RECORDED

93 NOV 11 AM 11:56

Robert J. Hollman
REGISTER OF DEEDS
OTTAWA COUNTY, MI

<u>Ottawa</u> (County)	Located In:	Corner Code #:
1. Public Land Survey	T 6N R 16W	K-9 (NE - Sec 26)
	T _____ R _____	Port Sheldon Twp.
	T _____ R _____	_____
	T _____ R _____	_____
2. Property Controlling in Section	S _____ T _____ R _____	_____
	S _____ T _____ R _____	_____
3. Miscellaneous Property in Sec.	S _____ T _____ R _____	_____
	S _____ T _____ R _____	_____

Register of Deeds Stamp & File Number

4. Lot No. _____, Recorded Plat _____
5. Private Claims _____

I, David R. Greer, in a field survey on September 13, 19 93, do hereby certify that under requirements of P.A. 74, Michigan P.A. of 1970, the corner points mentioned in lines 1 and 2 above were in conformance with regulations and rules therefore as required in the current manual of survey instructions of the United States Department of the Interior, Bureau of Land Management or by a decree of a Court of Law and/or that the corner points mentioned in lines 3, 4 and 5 above were in conformance with the rules of the Michigan Board of Land Surveyors or by a Decree of a Court of Law; established, re-established, monumented, re-monumented, recovered, found as expressed below:

NOTE: Not more than 4 corners, all in the same town and range, may be recorded on this certificate.

A	B	C	D	E	F	G	H	I	J	K	L	M
2	6	5	4	3	2	1						
3												
4	7	8	9	10	11	12						
5												
6	18	17	16	15	14	13						
7												
8	19	20	21	22	23	24						
9												
10	30	29	28	27	26	25						
11												
12	31	32	33	34	35	36						
13												

A. Description of original monument and accessories and/or subsequent restoration:

Recorded in Liber 5 Page 78 Dec. 20, 1983

K-9

Set cast iron monument

PP	NW	42.50
GP	SE	45.30
Tele Ped	SW	53.73
8" Maple	SW	90.80

B. Description of corner evidence found and/or method applied in restoring or reestablishing corner:

K-9

Found cast iron monument in monument box and accepted it as a careful and faithful perpetuation of the position of the original corner

PP	NW	42.20
GP	SE	45.30
8" Maple	SW	90.80


C. Description of monument for corner and accessories established to perpetuate locating the position of the corner:

K-9

C.I.M. in monument box

AZ - Michigan State Grid Direction

O.C. Remon tag & nail in NW Side 18" Ash	AZ.	199°01'	110.18'
O.C. Remon tag & nail in SE Side 10" Maple	AZ.	212°57'	90.91'
O.C. Remon tag & nail in S Side 8" Cherry	AZ.	285°04'	150.32'
P.K. & Cap 14091 in NE Side 20" White Pine	AZ.	124°33'	63.85'

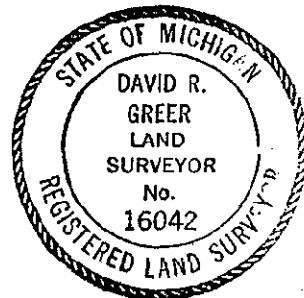

Signed by David R. Greer

Date SEPT. 13, 1993

Surveyor's Michigan License No. 16042