

SURVEY & REMONUMENTATION

DEC 01 1993

COMMISSION

For corners in

**OTTAWA COUNTY REMONUMENTATION
LAND CORNER RECORDATION CERTIFICATE
Filing Requirement of Act 74, Mich. P.A. 1970**

RECORDED

93 NOV 11 AM 11:55

Phyllis Kallman
REGISTER OF DEEDS
OTTAWA COUNTY, MI

<u>Ottawa</u> (County)	Located In:	Corner Code #
1. Public Land Survey	T <u>6N</u> R <u>16W</u>	<u>K-11 (NE Sec 35)</u>
	T _____ R _____	<u>Port Sheldon Twp.</u>
	T _____ R _____	_____
	T _____ R _____	_____
2. Property Controlling in Section	S _____ T _____ R _____	_____
	S _____ T _____ R _____	_____
3. Miscellaneous Property in Sec.	S _____ T _____ R _____	_____
	S _____ T _____ R _____	_____

Register of Deeds Stamp & File Number

4. Lot No. _____, Recorded Plat _____
5. Private Claims _____

I, David R. Greer, in a field survey on September 13, 19 93, do hereby certify that under requirements of P.A. 74, Michigan P.A. of 1970, the corner points mentioned in lines 1 and 2 above were in conformance with regulations and rules therefore as required in the current manual of survey instructions of the United States Department of the Interior, Bureau of Land Management or by a decree of a Court of Law and/or that the corner points mentioned in lines 3, 4 and 5 above were in conformance with the rules of the Michigan Board of Land Surveyors or by a Decree of a Court of Law, established, re-established, monumented, re-monumented, recovered, found as expressed below:

NOTE: Not more than 4 corners, all in the same town and range, may be recorded on this certificate.

	A	B	C	D	E	F	G	H	I	J	K	L	M
2	6	5	4	3	2	1							
3													
4	7	8	9	10	11	12							
5													
6	18	17	16	15	14	13							
7													
8	19	20	21	22	23	24							
9													
10	30	29	28	27	26	25							
11													
12	31	32	33	34	35	36							
13													

A. Description of original monument and accessories and/or subsequent restoration:


Recorded in Liber 1 Page 377, May 11, 1972
K-11
Found Steel Bar from County Ties Replace with
Cast Iron Monument inscribed "Ottawa County Section Corner"
Nail in face 16" Maple N70°E 90.76'
Nail in face of Light Pole SW 35.72'
Nail in face of Triple 12" Maple S70°W 82.35'
CL Street Sign SE 35.52'

B. Description of corner evidence found and/or method applied in restoring or reestablishing corner:

K-11
Found cast iron monument in monument box and accepted it as a careful and faithful perpetuation of the position of the original corner
Nail in face of 16" Maple N70°E 90.76'
Nail in face of Light Pole SW 35.72'
CL Street Sign SE 35.52'

C. Description of monument for corner and accessories established to perpetuate locating the position of the corner:

K-11
Raised C.I.M. in monument box with O.C. Remonument Iron & Cap
AZ - Michigan State Grid Direction
O.C. Remon tag & nail in NE side 14" Maple AZ. 300°33' 121.59'
O.C. Remon tag & nail in S Side 26" Maple AZ. 72°01' 91.42'
O.C. Remon tag & nail in NE Side 6" Maple AZ. 127°48' 94.56'
Centerline 4" Maple, 1' Above Ground AZ. 212°02' 69.39'
Centerline 4" Maple, 1' Above Ground AZ. 231°51' 63.98'

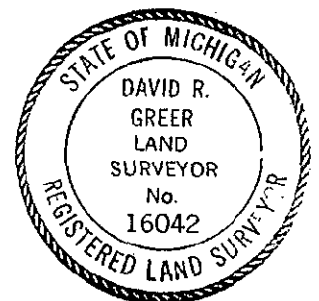

Signed by David R Greer Date Sept. 13, 1993

Surveyor's Michigan License No. 16042