

**SURVEY & REMONUMENTATION**

OCT 24 1994

COMMISSION

**OTTAWA COUNTY REMONUMENTATION**

**LAND CORNER RECORDATION CERTIFICATE**  
Filing Requirement of Act 74, Mich. P.A. 1970

RECORDED

94 OCT -7 PM 12:32

*Polychia Robinson*  
REGISTER OF DEEDS  
OTTAWA COUNTY, MI

For corners in  
Ottawa

	(County)	Located In:		Corner Code #
		6N	16W	
1. Public Land Survey		T	R	K-12 (W 1/4-36) Port Sheldon Twp.
		T	R	
		T	R	
		T	R	
2. Property Controlling in Section	S	T	R	
	S	T	R	
3. Miscellaneous Property in Sec.	S	T	R	
	S	T	R	
4. Lot No. _____, Recorded Plat _____				
5. Private Claims _____				

Register of Deeds Stamp & File Number

Gerald T. Ford

April 1,

94

I, \_\_\_\_\_, in a field survey on \_\_\_\_\_, 19\_\_\_\_, do hereby certify that under requirements of P.A. 74, Michigan P.A. of 1970, the corner points mentioned in lines 1 and 2 above were in conformance with regulations and rules therefore as required in the current manual of survey instructions of the United States Department of the Interior, Bureau of Land Management or by a decree of a Court of Law and/or that the corner points mentioned in lines 3, 4 and 5 above were in conformance with the rules of the Michigan Board of Land Surveyors or by a Decree of a Court of Law; established, re-established, monumented, re-monumented, recovered, found as expressed below:

**NOTE: Not more than 4 corners, all in the same town and range, may be recorded on this certificate.**

	A	B	C	D	E	F	G	H	I	J	K	L	M
2	6	5	4	3	2	1							
3													
4	7	8	9	10	11	12							
5													
6	18	17	16	15	14	13							
7													
8	19	20	21	22	23	24							
9													
10	30	29	28	27	26	25							
11													
12	31	32	33	34	35	36							
13													

A. Description of original monument and accessories and/or subsequent restoration:

K-12			K-12		
Government Land Office Survey Notes			Recorded in Liber 5 Page 99		
1832 - Surveyor, Calum Britian			Cast iron monument		
Post			Guy Pole	NW	47.95'
24" Hemlock	S50°E	11 links	14" Black Cherry	SW	69.08'
18" Hemlock	S70°W	16 links	10" Oak	ESE	54.11'
			Power Pole	NE	38.38'

B. Description of corner evidence found and/or method applied in restoring or reestablishing corner:

K-12

Found cast iron monument in monument box and accepted it as a careful and faithful perpetuation of the position of the original corner

Found nail & cap in guy pole	AZ 312°23'	47.94'
Found nail in face 12" Oak	AZ 101°46'	54.10'

P.A. 345 OTTAWA COUNTY

PEER APPROVED 6/20/94

*Gordon D. Fedor*


C. Description of monument for corner and accessories established to perpetuate locating the position of the corner:

K-12

Cast iron mon in monument box

AZ = Michigan State Grid Direction

O.C. Remon tag & nail in SW face 6" Oak	AZ. 312°23'	85.42'
NE Cor Conc. Hse Foundation 0.2' Below Siding	AZ. 222°20'	126.69'
SW Cor. Conc. Garage Fnd 0.2' Below Siding	AZ. 138°52'	146.24'
O.C. Remon tag & nail in NE face P. Pole	AZ. 165°01'	118.07'

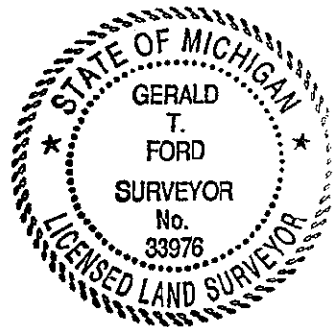

Signed by Gerald T. Ford

Date July 13, 1994

Surveyor's Michigan License No. 33976